Feb. 12-1872 -
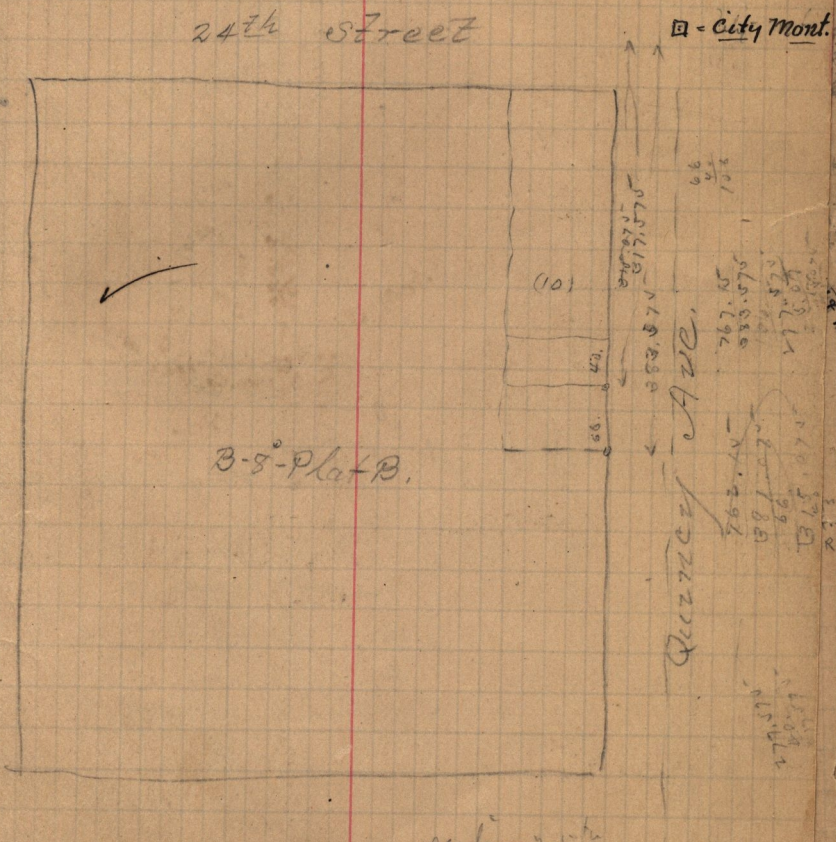
deed from John Wheelwright & Phebe V. Smith
Part of Lot 10- B-8- Plat B. Ogden City Survey
Beg. 4 rods N. of S.E. cor. said Lot. N. 8 rods
W 40 ft E 8. rods S 40 ft ft to beg. (6-440)
To be surveyed.