

Feb 27<sup>th</sup> 1892.

Survey made for Albert Allen in S.W. Quar. Sec 5 T. 5. N. R. 1-W.

August Lundquist and John Baird, Chs


Needs do not conform to fence

Oct 11-1893. Set of map.

2653.0 = 14

2259.78 = Jenkins ditch N.E.

2177.78 = ctr. track abt 300 S. of P.C.

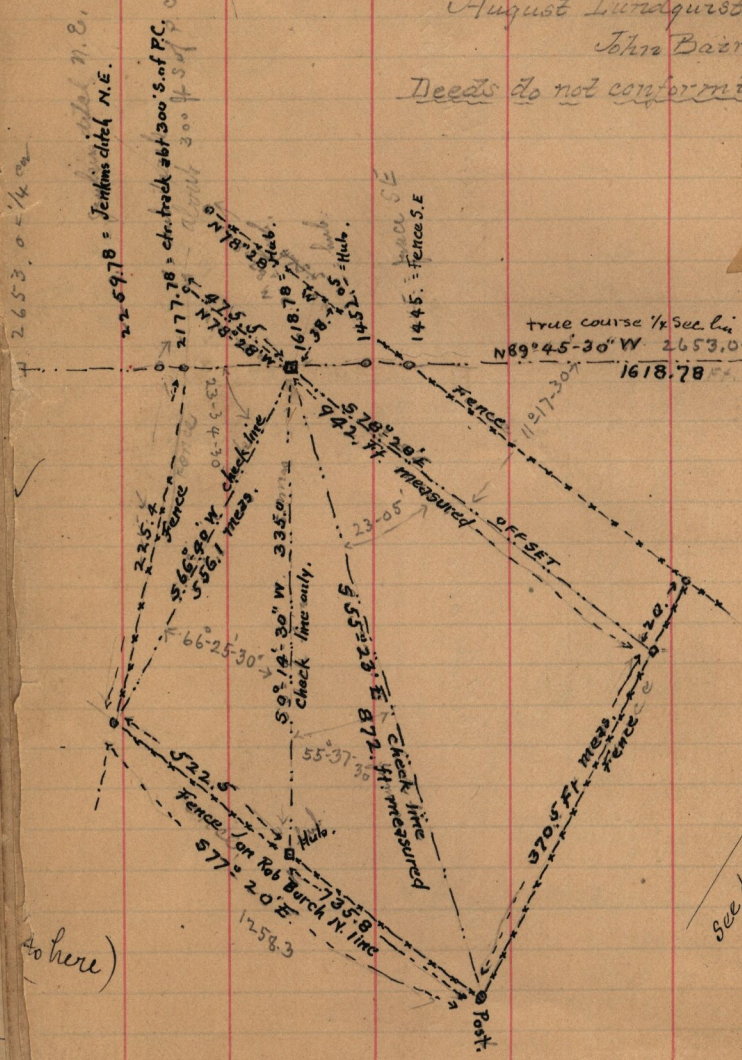

See b. p. 1  
centre Sec. 5 T. 5 R. 1. W.

(to here)

See plat Book page 86  
See plat 1/4 page