Continuation of Shaw Survey.

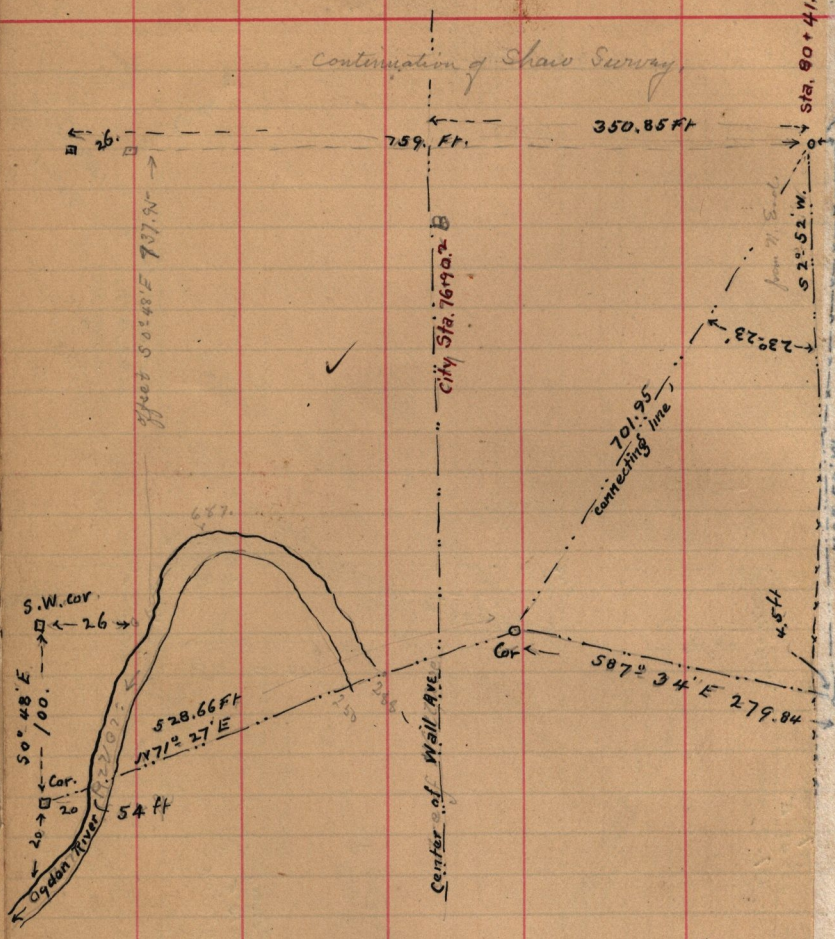

Note

No 1 Francis Shaw
No 2 Harriet O. Shaw
" 3 Robert R. Shaw
" 4 Maria Folker Sho
" 5 John Shaw
" 6. James H. Shaw
" 7 Jedediah M. Shaw

8 = Myrtle Sh
9 = Walter Sh