orchard 100.(2) picket fence 20.(2) Barn 200. to 300.
Reservoir 75.(2) log house 25.00 - cross fence 10.00

see book J. Field notes page 76

Surveyed for C.E. Laynes, Mar 15-1892.

Deed from J. M. Langedorf & wife to Marcia Laws
Beg. 16. ft E. of N.W. cor. Lot 8. B-2. Plat "A"
— S. 10. rods — E. 50. ft, N. 10. rods W. 50. ft to
beg. — Book 16. page 167. — Self & Baird chain
centre 21st — Street. 763.85 ft → City Mon.

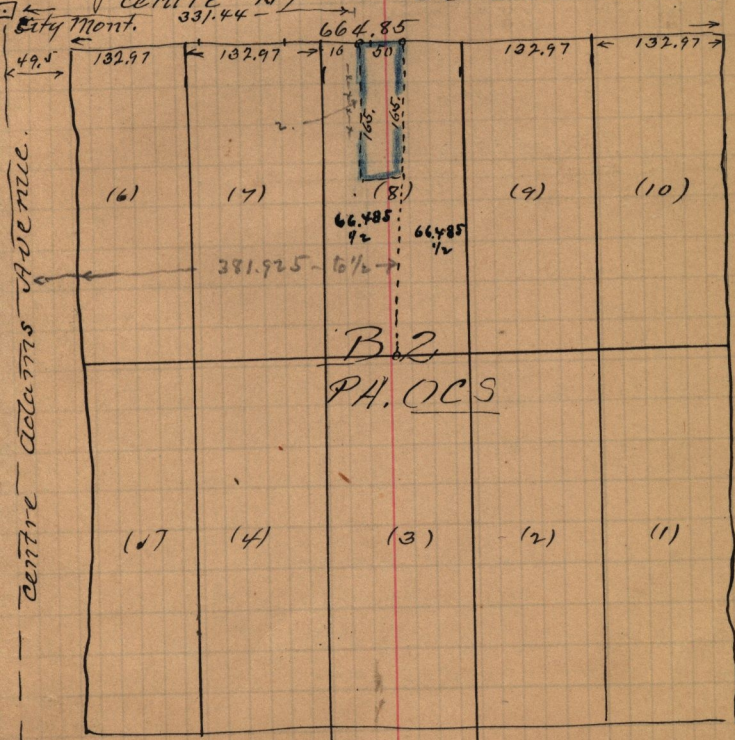

From N.E. cor of above 49.5 ft S. to point .8. ft W. of N.E. cor of brick house size 34 E & W. by 16. N & S.