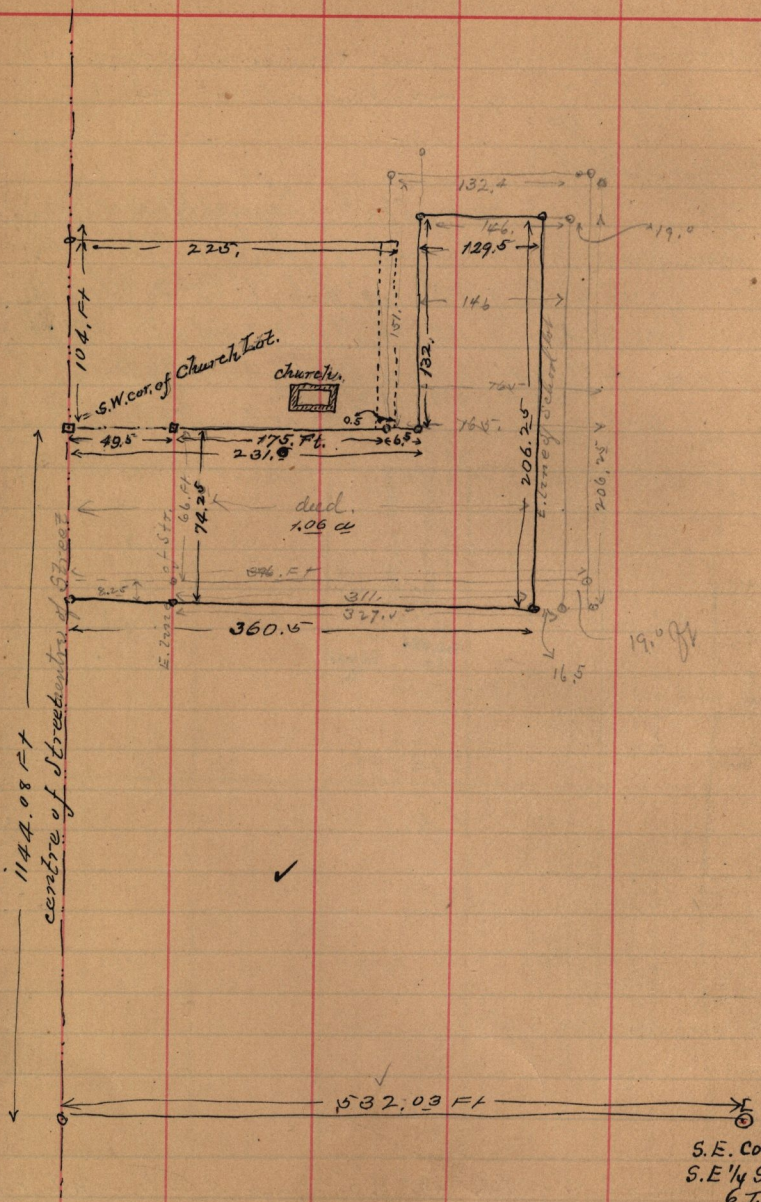

S.E. Cor
S.E 1/4 Sec
6 T.6.
N.R.1.W.