Apr.

— 56 —
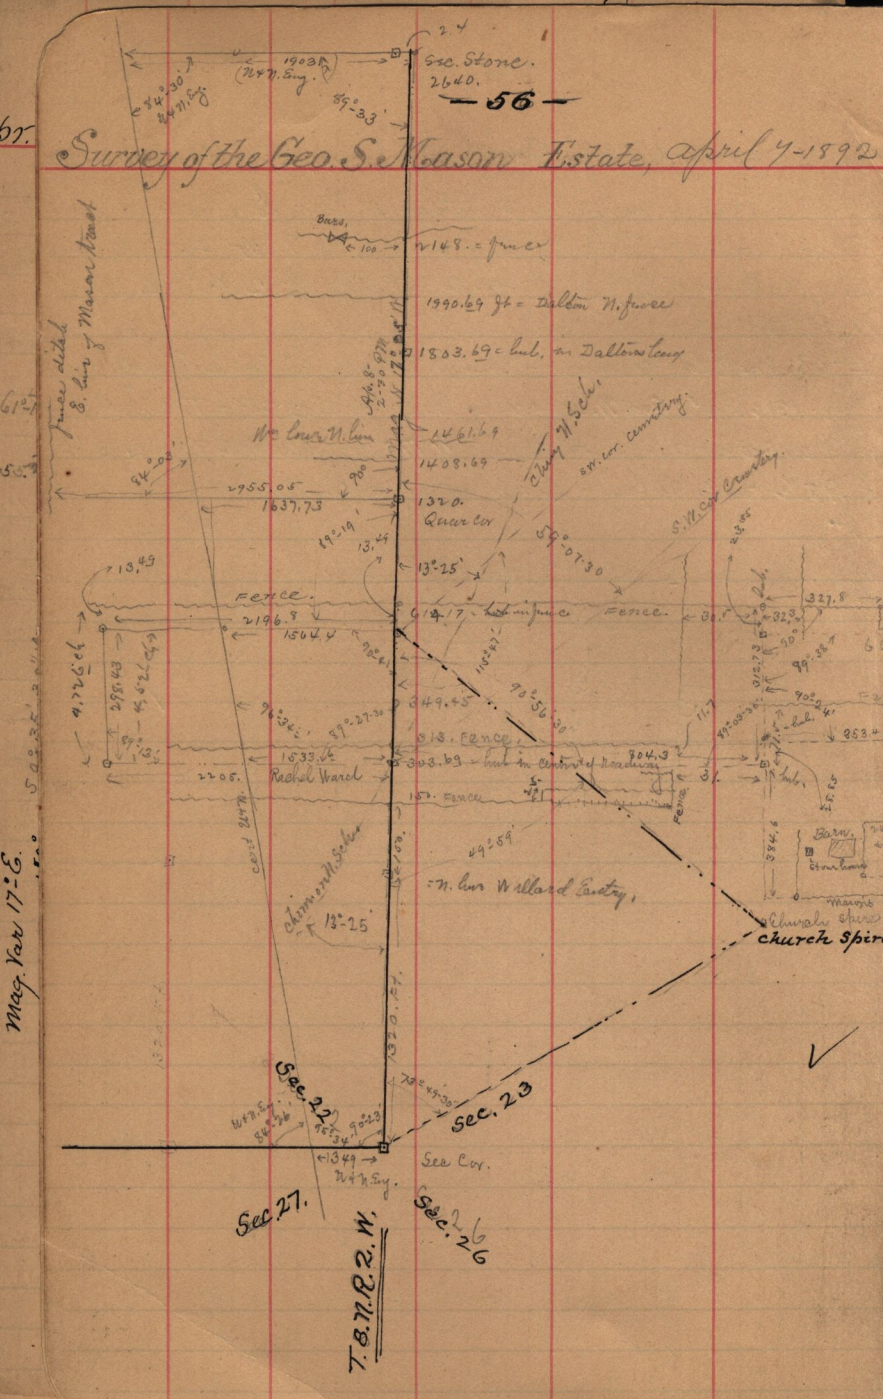
Survey of the Geo. S. Mason Estate, April 4-1892