


April 13-1892 - Survey of a plat

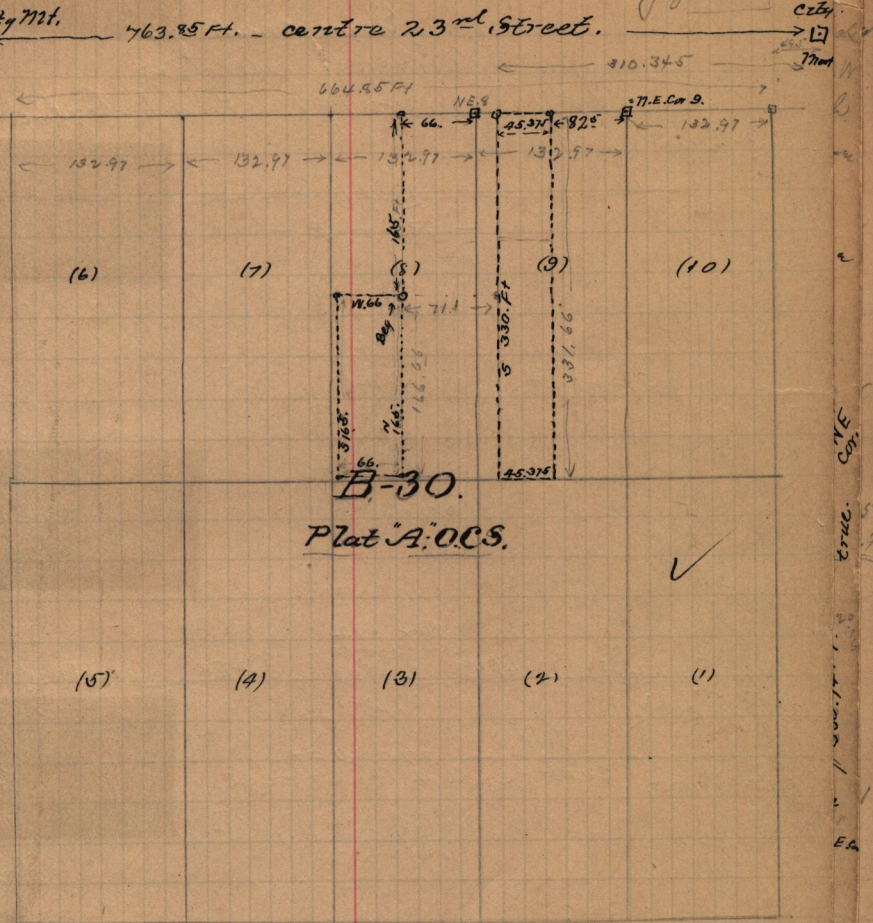

138. Weber Records, - Mary C. Barker to A. Kuhn, - Beg. 5 rods, W.
 of N.E. Cor. Lot 9. B-30. Plat "A." O.C.S. - W 2 3/4 rods, S. 20. rods, E. 2 3/4 rods,
 N. 20. rods to beg. - 5-281. - Mary C. Barker to A. Kuhn, Beg. 4 rods
 W. & 10 rods S. of N.E. Cor. Lot 8. B-30. Plat "A." W. 4 rods, S. 10. rods
 E. 4 rods, N. 10 rods to beg.