


Apr.

April 13-1892-

Survey made for
Charles Tillotson

The E 1/4 of Lot 3 - B-10. Plat B. Ogden
Survey.

762.33 Ft
centre Meadison Ave

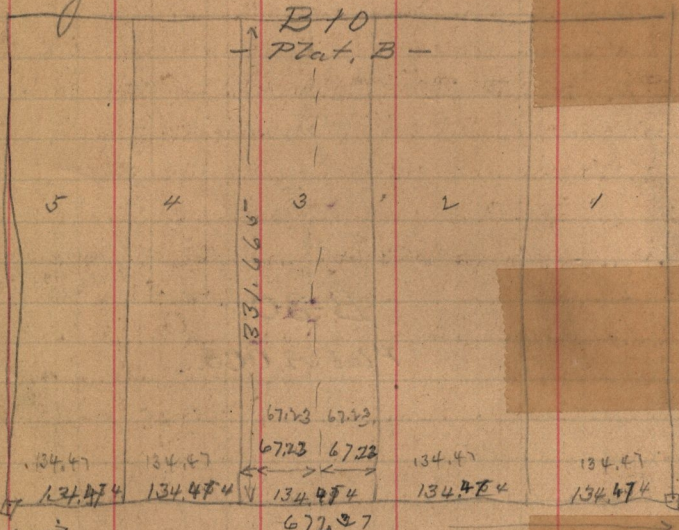

Mar. 17-92

City Mont. centre 770.23 Ft
 Re-measured April 13-1892
 self & Baird

