— April 14 - 1892.

E-247. Weber. Records. — David Moore to Diana Herrick
Beg. 11.36 ch S. of N.W. cor. of N.E 1/4 Sec 21. T.6. N. R.1.W
Thence E 1 1/2 rods - S 12.59 ch. - E 15.875 ch. N 12.59 ch
W 15.875 ch. to beg. Baird & Lester Moore, chainers

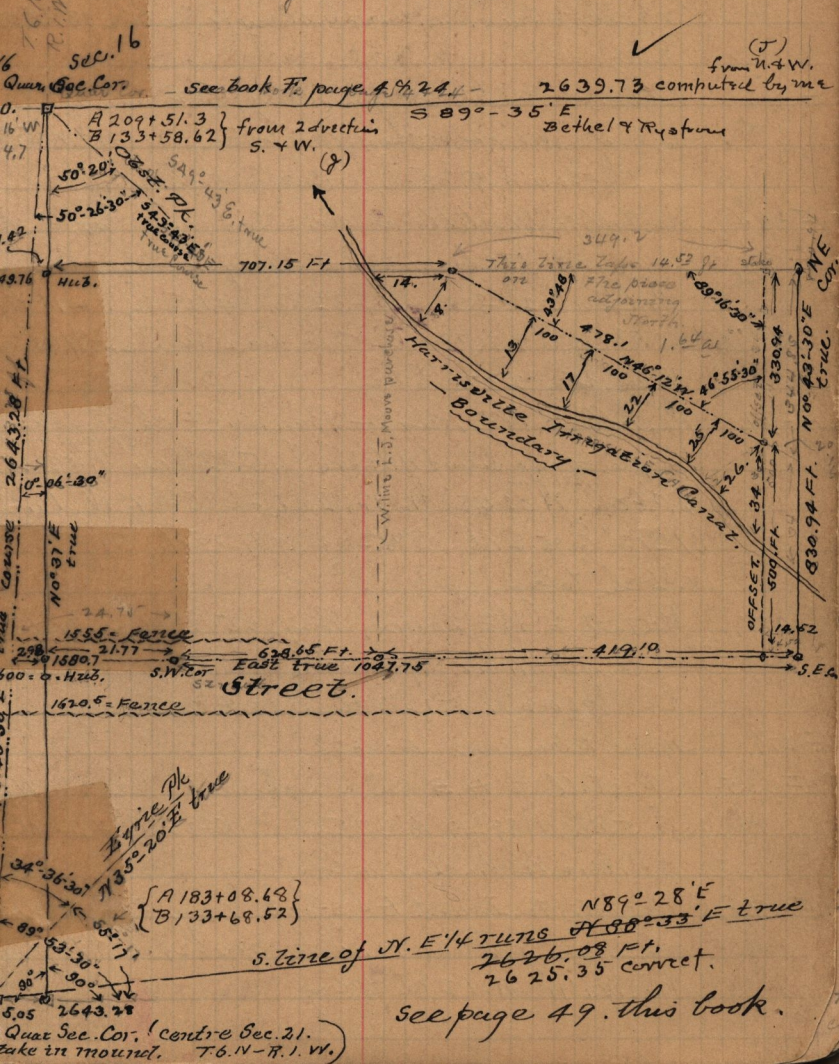

see page 49. this book.