— 68 —

John Baird & J. T. McDonald
Chainmen

see Book G - pages 142 -
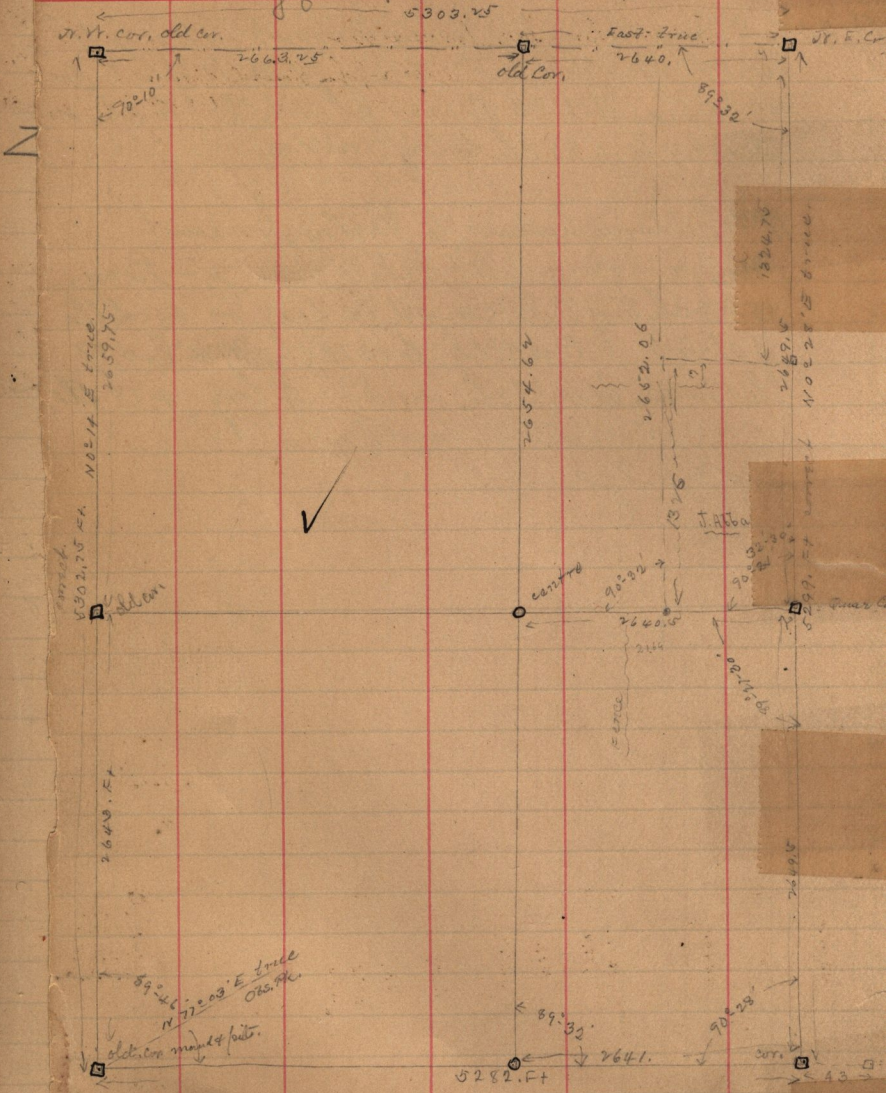
Survey of Sec. 17 T. 5 N. R. 2 W. April 20 - 1892 -