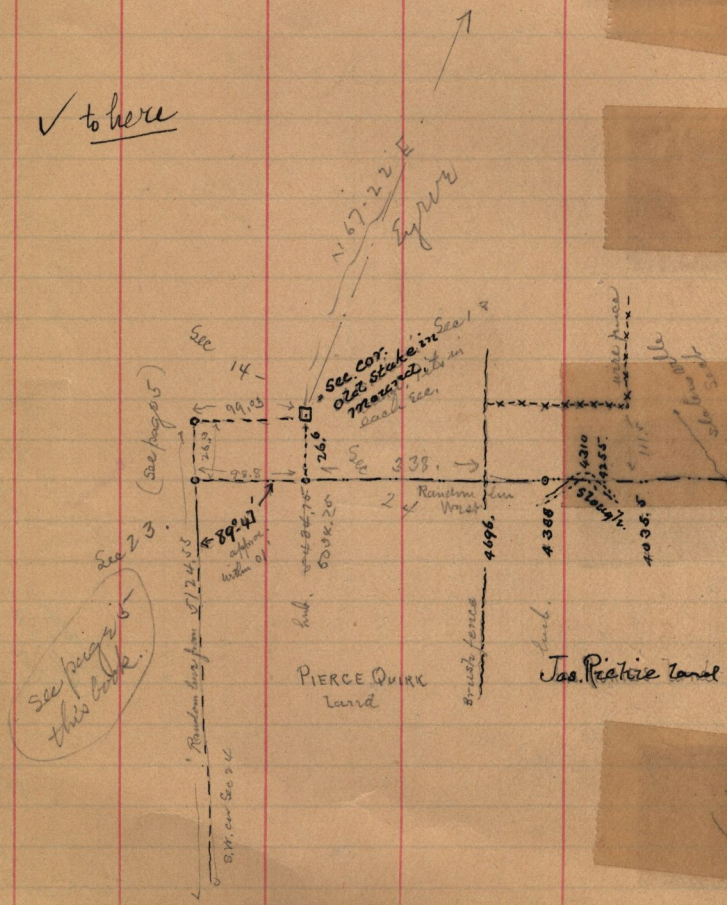— April 22 - 1892 -