


Maze Ave.

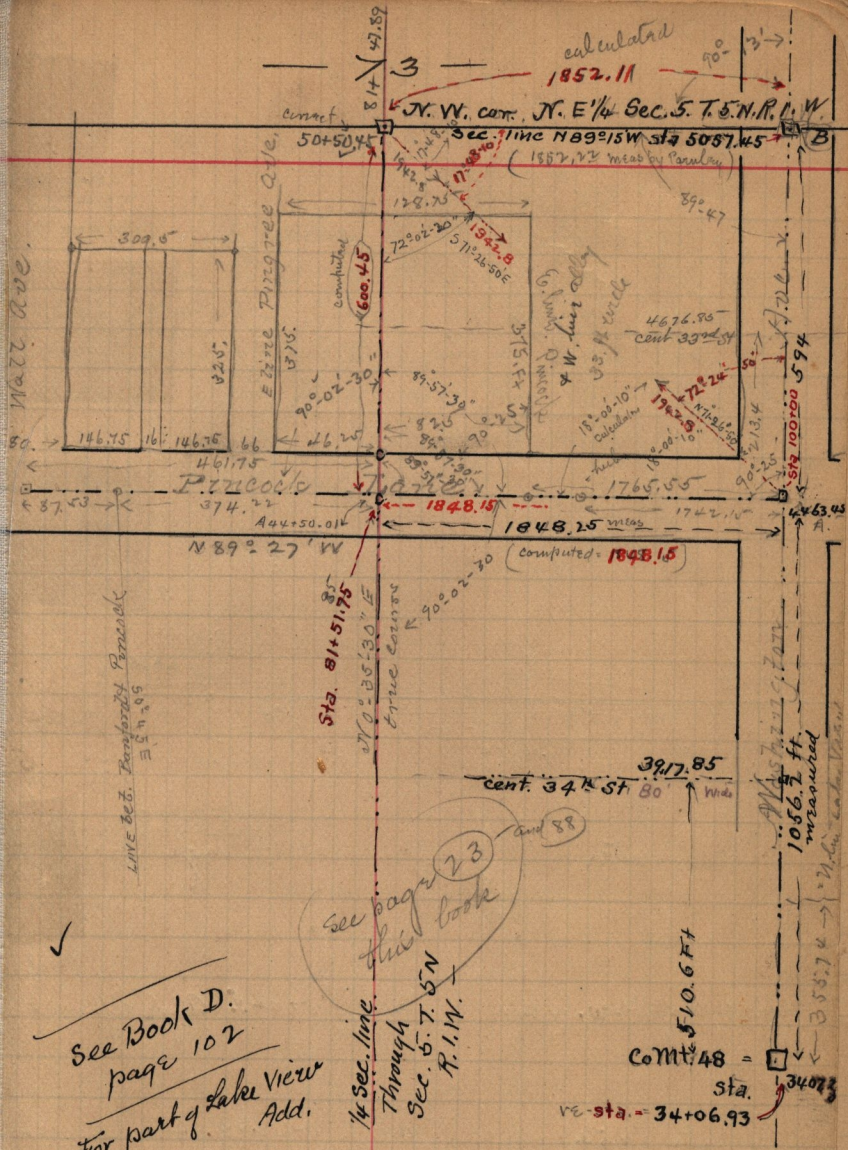

LINE bet. Township 4. Pennock
E 1/2 Sec. 5

See Book D.
page 102
For part of Lake View
Add.

See page 23
of this book

1/4 Sec. line
Through
Sec. 5. T. 5. N.
R. 1. W.

References to Mont No 48
 SE 36.7 tal pole $N 41^{\circ}$ to R.M. B. pole
 N.W. 79.6 Paint Oil + glass sign post
 S.E. 72.4 N.W. cor post to premises
 No 3468.
 S 102.2 to N. gace Phone pole