an error must have been made by the chain bearers in the meas. of the S. line of Sec. 10. T. 7. N. R. 7. W.

see book J. page 123

N.E. Cor. Sec
T. 9. N. R. 2. W
(See page ½)

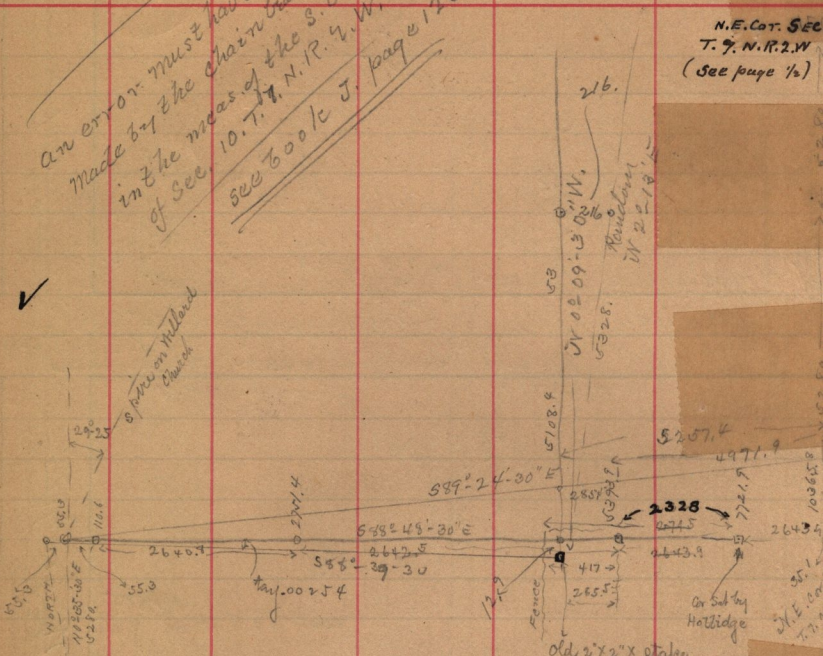

Old 2"x2"x stake 1 ft above ground. marked III notch

should remain center △ 8+57.7 Angle Right

8

7

6

May be swing 8 ft w. by curve △ 5+04.5 Angle left. 33°-0

5

4

swing center 6 ft to left with curve △ 3+55.33. Angle left 28°-40'

3

2

1

with curve.
ditch center to be swung 12 ft to left ○ 0+70 = Angle left 30°-00'

□ sta 0. on North bank of River at Clear Pond

alignment of Mill ditch