


April 29th 1892

not recorded - D. Jenkins to Albert Scowenst.

Plat Lot 4. B-12. Plat "A" Ogden City Survey.

beg. 78. ft N. of S.E. cor. of Lot. 4. thence N. 110. ft more or less to N. line of S. 1/2 of Lot. thence N. 54. ft. S 110. ft more or less to pt N. of beg. E 54. ft to beg. subject to water course along South Side of said Lot.

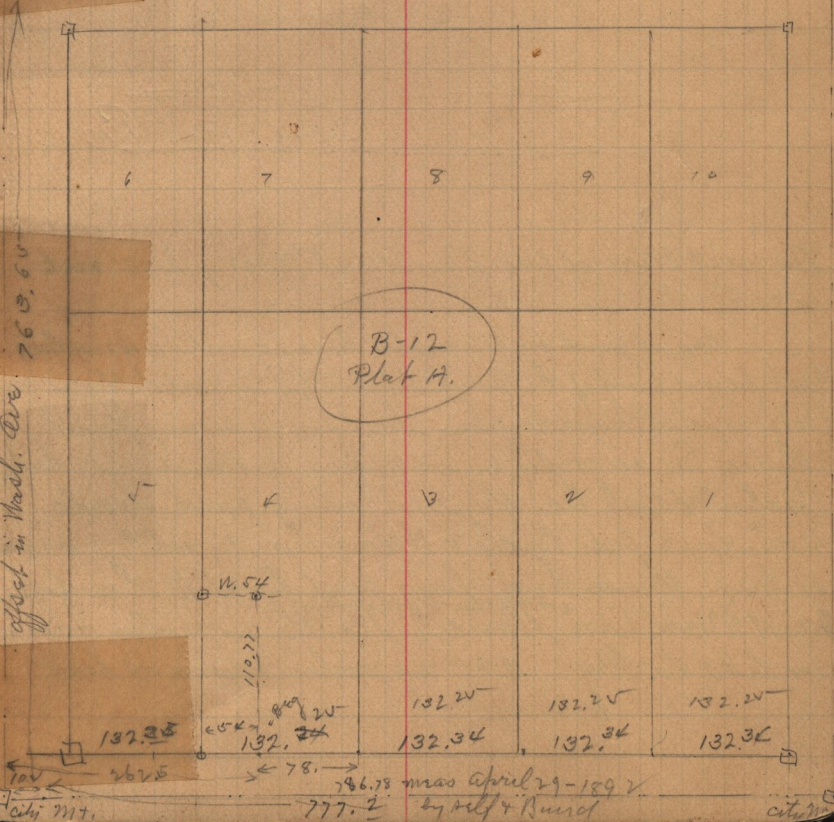

affect in Wash. Ave. 763.60

city mt.

ence. ce