




City Mont

cent. 23rd St.

City Mont

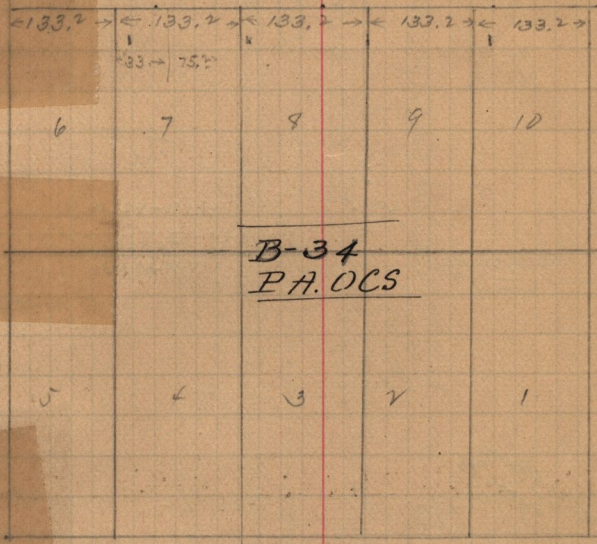

B-34
P.A. OCS

cent. Lincoln Ave.

cent. 24th Street
765

90.07

City Mont

City Mont