


May 11-1892

Survey made for N. Tanner, jr. in South  
 Oden Survey surveyed the shaded tract.  
 Self + Baird chainm.

contrary to the  
 actual distances  
 called for on Map  
 of Dunns Add  
 Tanner insisted on  
 beginning his  
 lots from the  
 Fence →

Fee 5.00  
 Paid Baird 1.00

✓

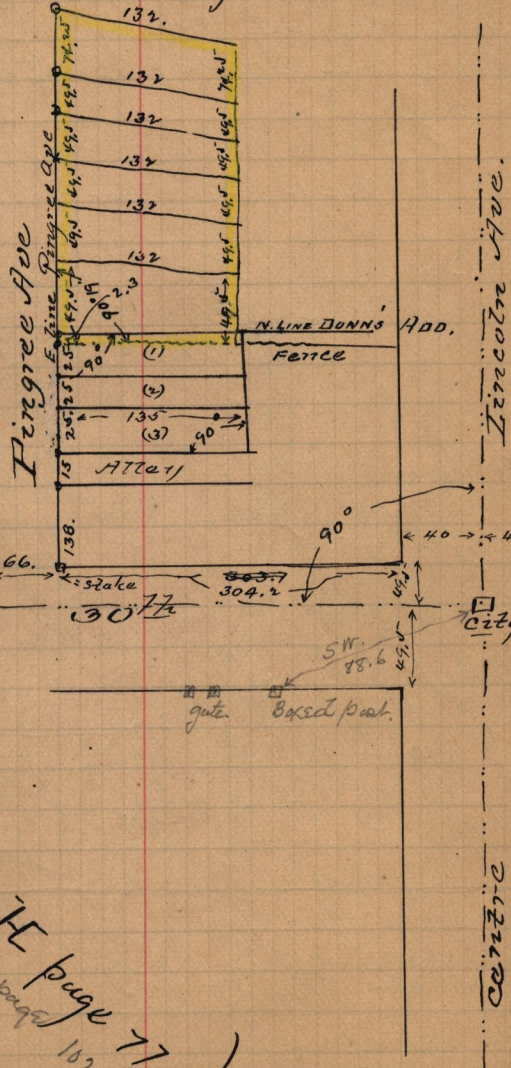

See also Book H page 77  
 See also Book J - page 102

49.5  
 138.0  
 50.0  
 50.0  
 277.5