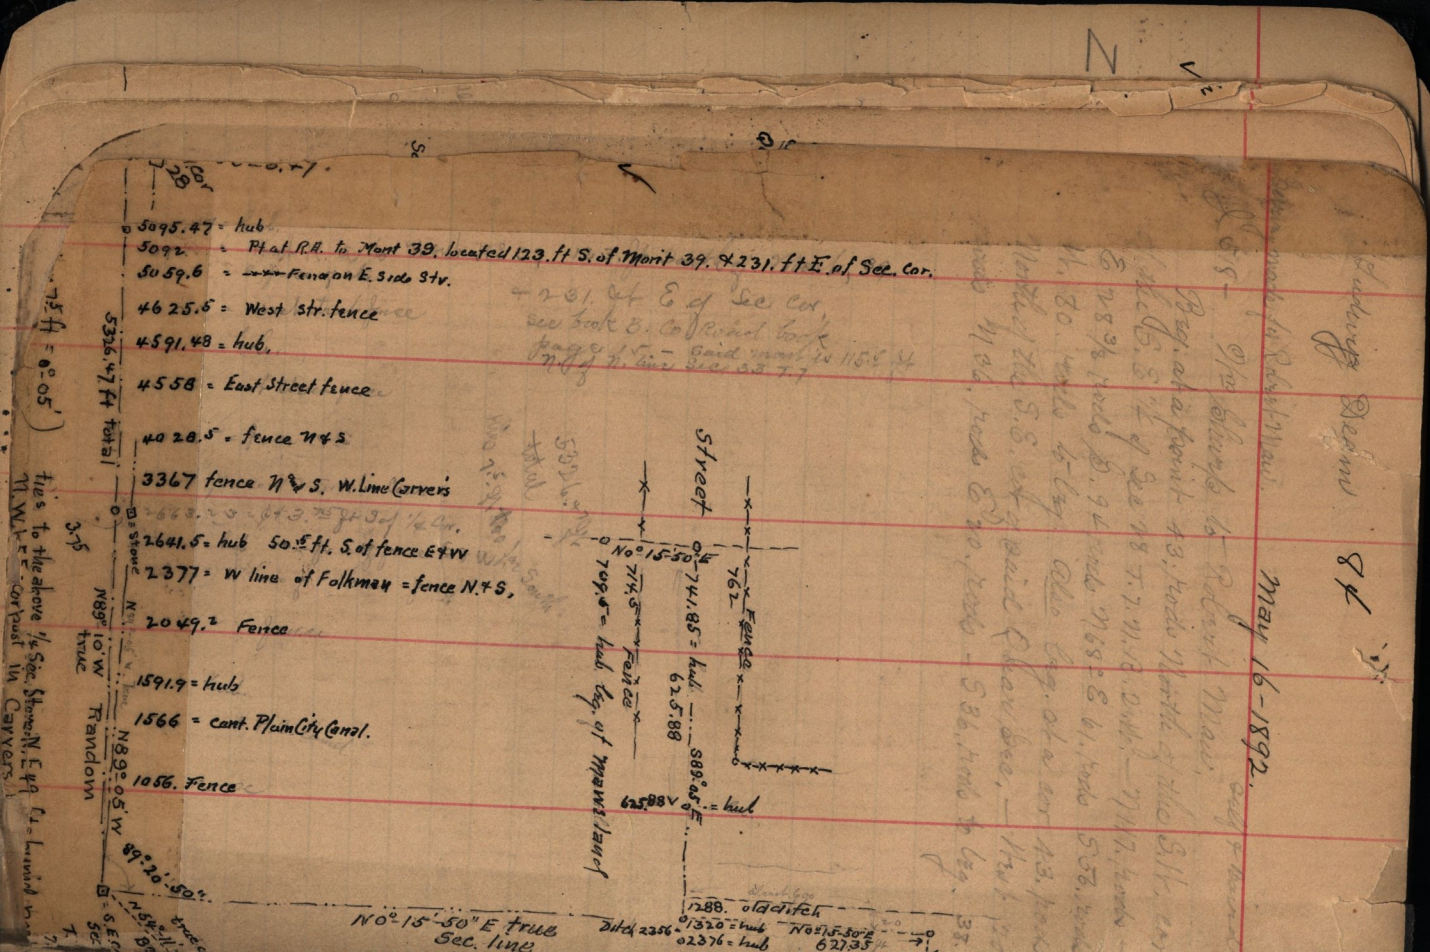
5095.47 = hub
5092 = Pt at S.R. to Mont 39. located 123. ft S. of Monit 39. & 231. ft E. of Sec. Cor.
5059.6 = Fence on E. side 37v.
4625.6 = West str. fence
4591.48 = hub,
4558 = East Street fence
4028.5 = fence N & S
3367 fence N & S. W. Line Carvers
2641.5 = hub 50.5 ft. S. of fence E & W
2377 = W line of Folkman = fence N. & S.
2049.2 Fence
1591.9 = hub
1566 = cent. Plain City Canal.
1056. Fence
5326.47 ft total
N89° 10' W true
N89° 05' W Random
89° 20' 50"
N0° 15' 50" E true Sec. line
Street
N0° 15' 50" E
741.85 = hub
762
Fence
625.88
S89° 05' E = hub
709.5 = hub Cen. of Main Lane
1288. old ditch
Ditch 2256
0320 = hub
0236 = hub
N0° 15' 50" E
627.35