


(See also pages 33 this book)

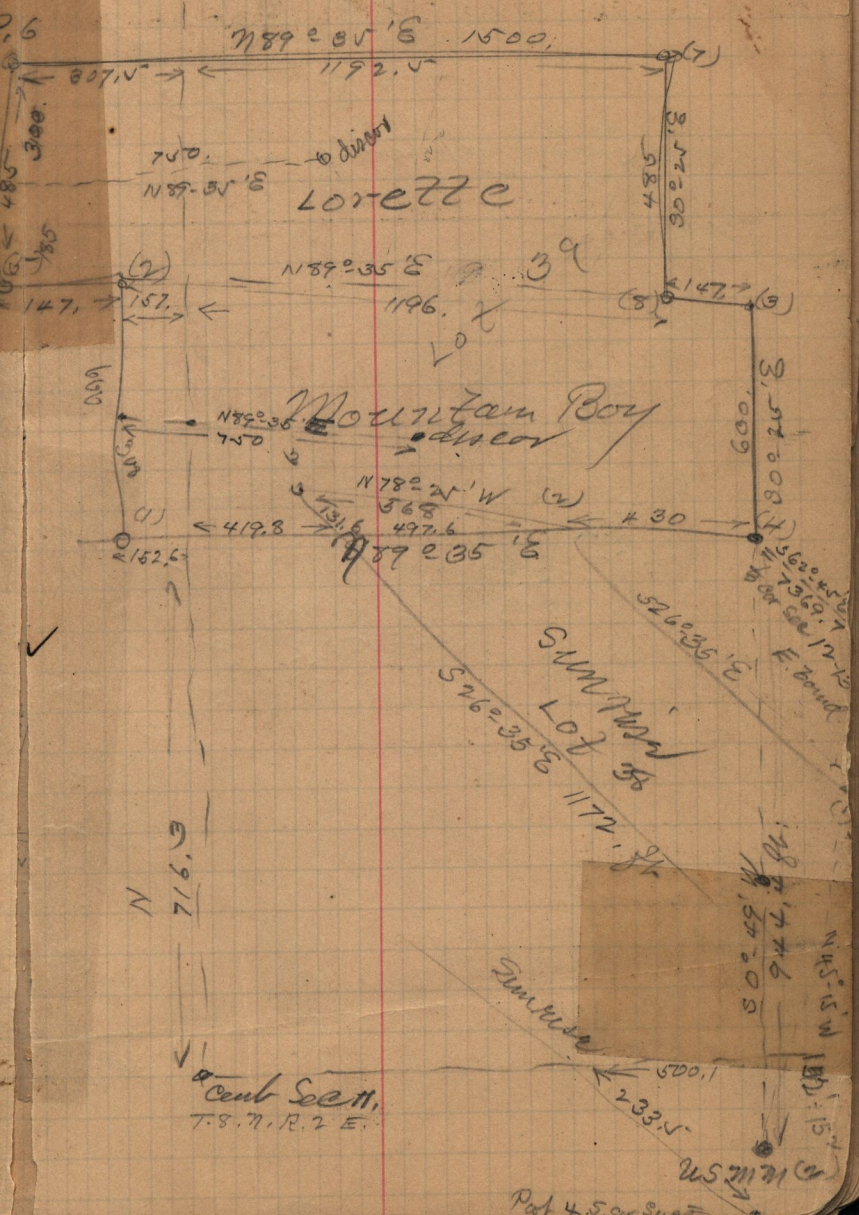

Cent Sect 11,  
T. 8. N. R. 2 E.

Pat 4.5 or 5.11