


- 90 -

T. 8 N. R. 2.8  
N.E. 1/4 Sec 11

true N 78° 25' W.  
Perms. 580. ft

N 78° 25' W 568.

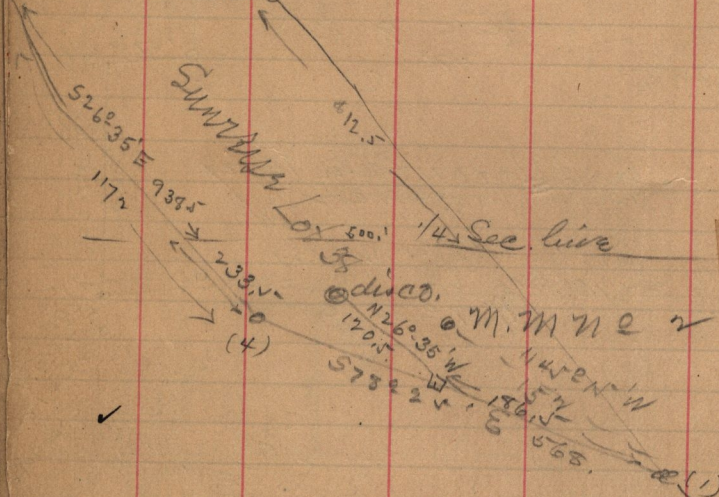

5700.10  
 6862.50  
 1213  
 668