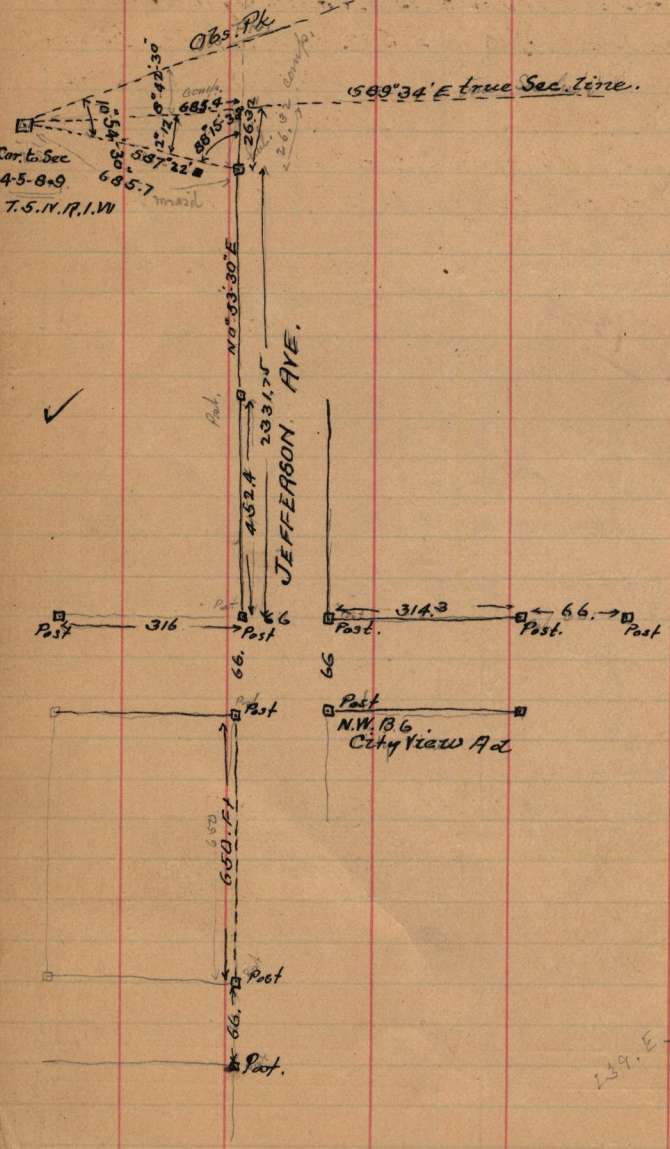— May 26th 1892 —