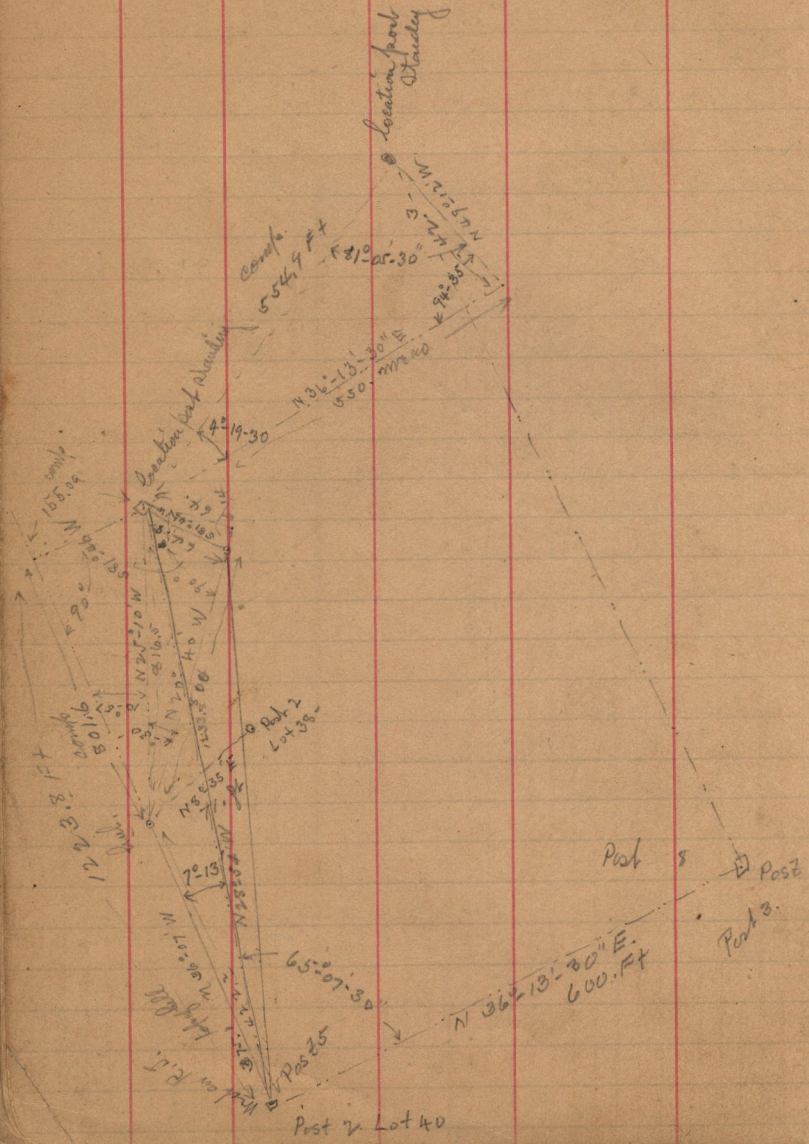June 6-1892 - Survey of the Red Jacket Lode
Paradise Mining Di