


June 7 - 1892

trans. part by aspen  
tree 10" diam.

Location Post  
Red jacket lane  
Northernmost post  
standing

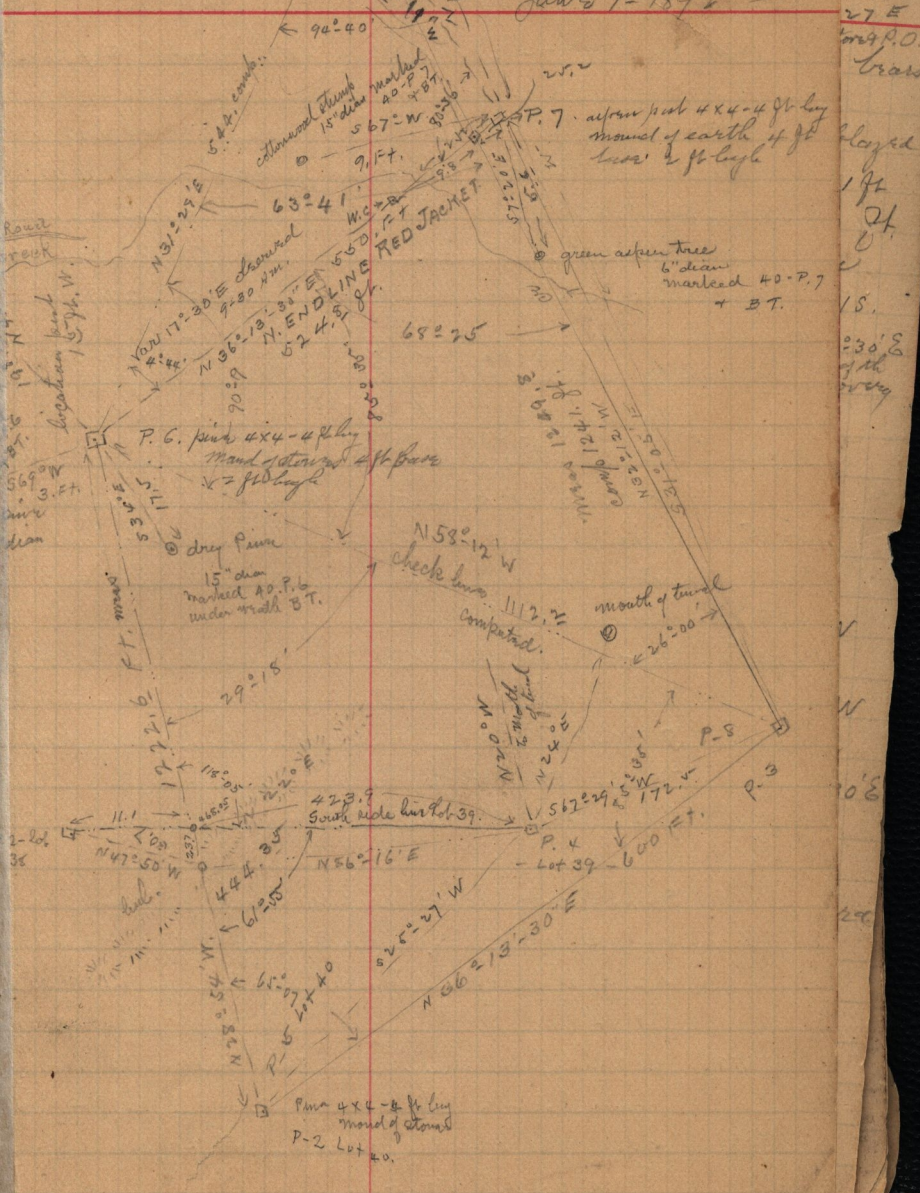

27'E  
long P.O.  
cross

played  
19 ft  
24

18.  
230' S  
of the  
very

V

N

10' E

20'