

Queen of the Hills (mining claim)

From post 4 - Lot 40, a pine tree bears  
30" diam blazed 7 ft along ground & marked 40-  
P-4. & on blaze 1 ft from ground marked B.T.  
bears  $N 18^{\circ} E$  18. ft. From Post 4, a pine tree 24  
diam marked 40 bears  $S 80^{\circ} E$  107. ft.

U.S.M.M. N 22, from Post 4

bears  $S 89^{\circ} 09' W$ .


From P-4, the W. gable of Platina

Shaft House bears  $S 82^{\circ} E$

From DIS. 40, Queen of the Hills, a pine tree 30" diam  
bears  $N 60^{\circ} E$  27.5 ft. also a pine stump  
15" diam bears.  $S 35^{\circ} W$  20. ft.

From post. At Queen Hills DIS. the E gable of LAWS  
2 Story House in LA PLATA TOWN.

From DIS. Queen of Hills a shaft 6" deep 6" sq  
bears  $S 40^{\circ} E$  8. ft.

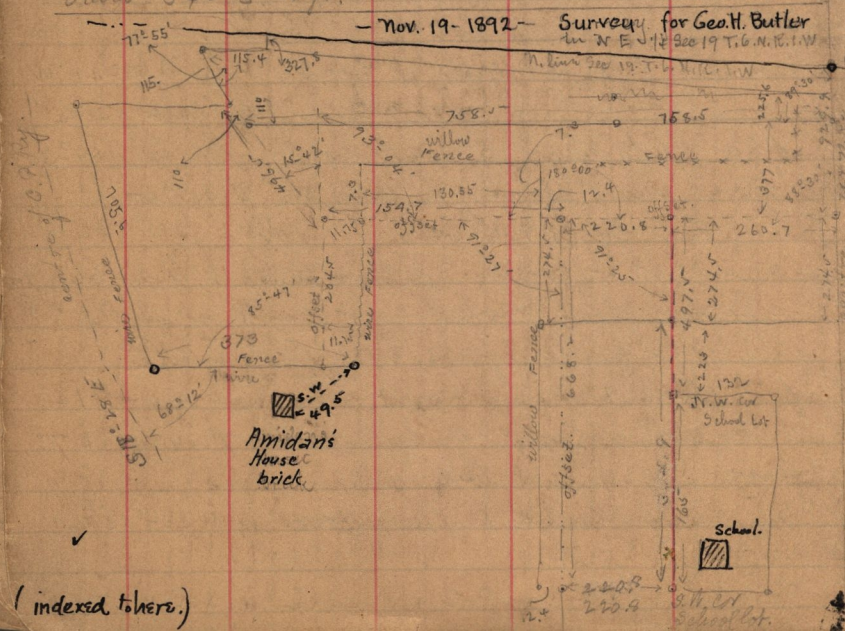

(indexed to here.)