


144  
& Book H-15

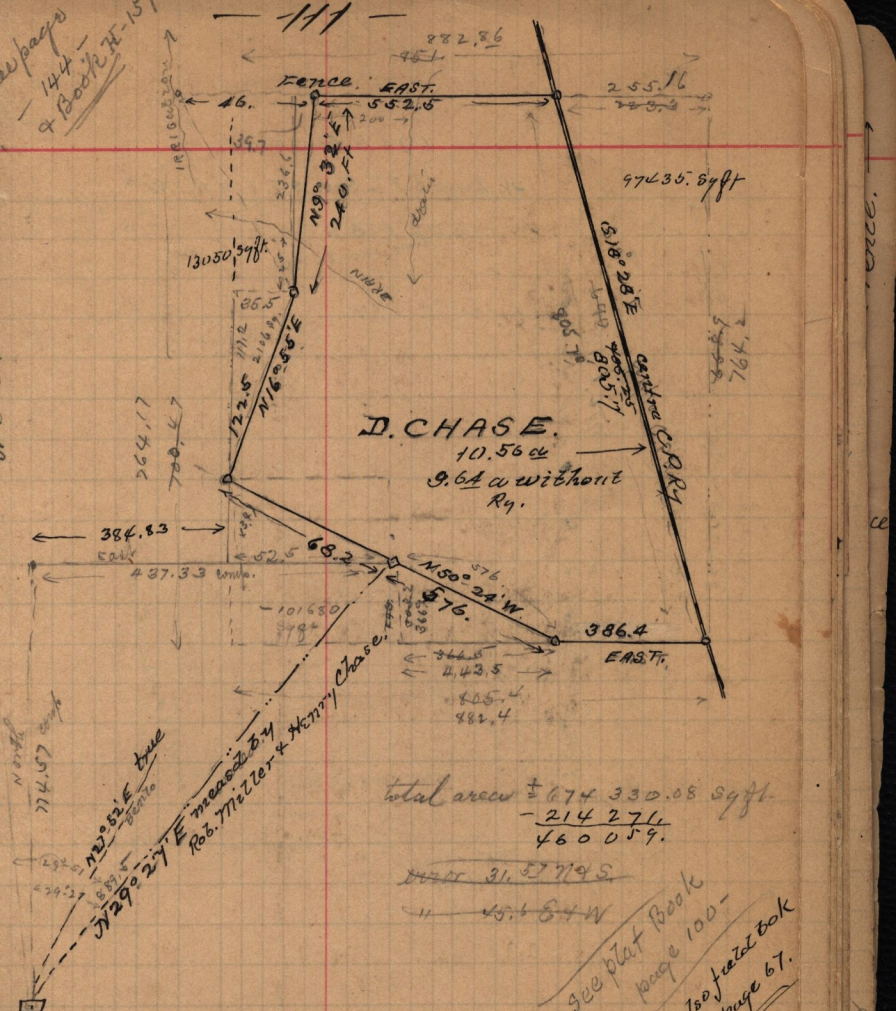

D. CHASE.

10.56 ac  
9.64 ac without R<sub>9</sub>.

total area ± 674 330.08 sqft.  
- 214 271  
460 059.

31 57 79 S  
45 6 84 W

see plat Book  
page 100-  
J. page 67.

S.W. Cor.  
E. 1/4 Sec 1  
I. G. N. R. 2. W.

JUNE 23<sup>rd</sup> 1892  
Survey made for  
D. Chase, in Sec 1.  
I. G. N. R. 2. W.  
mistake by chainman  
caused an extra trip  
on the following day.