


— July 4-1892 —  
Survey of Porter Ave.  
— for T. GIBBONS —

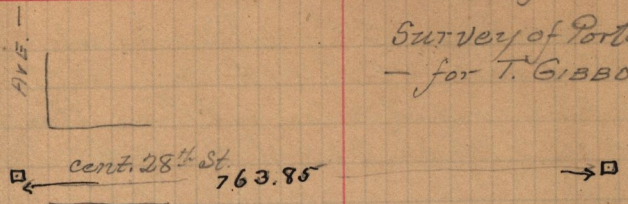

cent. Jeff. Ave.

