Survey for Jos. Barker

Jos. Barker & Wm Montgomery July 20 - 1872 -

Part of description of deed from Chas E. Clarke to Joseph Barker. N. 567

Beg. 12.81 ch S. of N.E. cor of col N.E¼ Sec 4 T. 6. N R. 1. W - thence N. 12. ch N 75°-W 2.45 ch N 83°-15' W 2.02 ch S 14°-30' W 1.03 ch E 4.62 ch to beg.

Also Beg. 18.12 ch S. of same Sec. cor - E 4.12 ch W 1. ch N 17°-W 4.35 ch E. 2.27 ch to beg
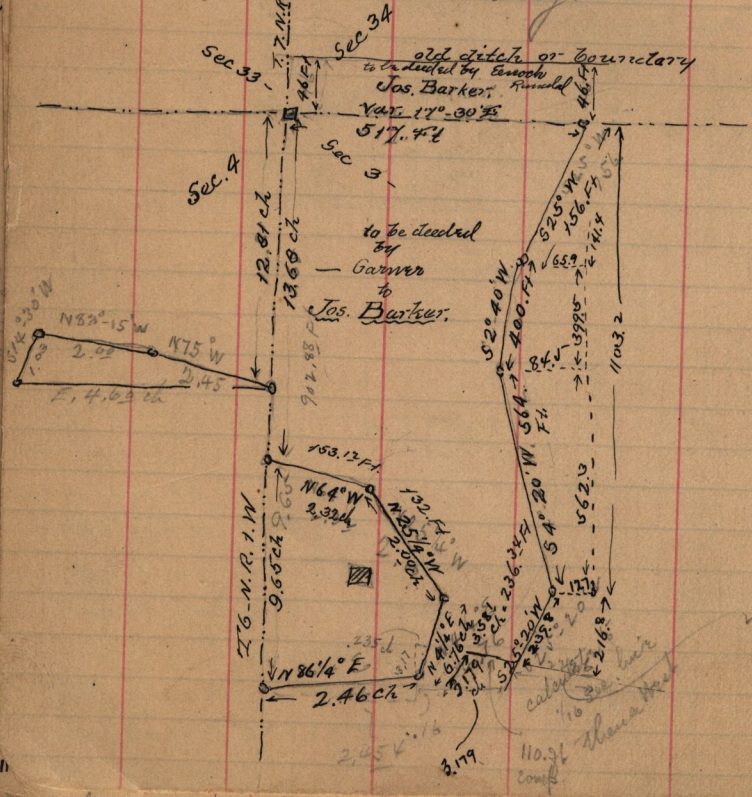
Also Beg. 13.48 ch S. of said Sec. cor S. 9.65 ch. N 86¼° E 2.46 ch N 4¼° E 6.72 N 25¼° E 2. ch N 64° W 2.32 ch to beg.