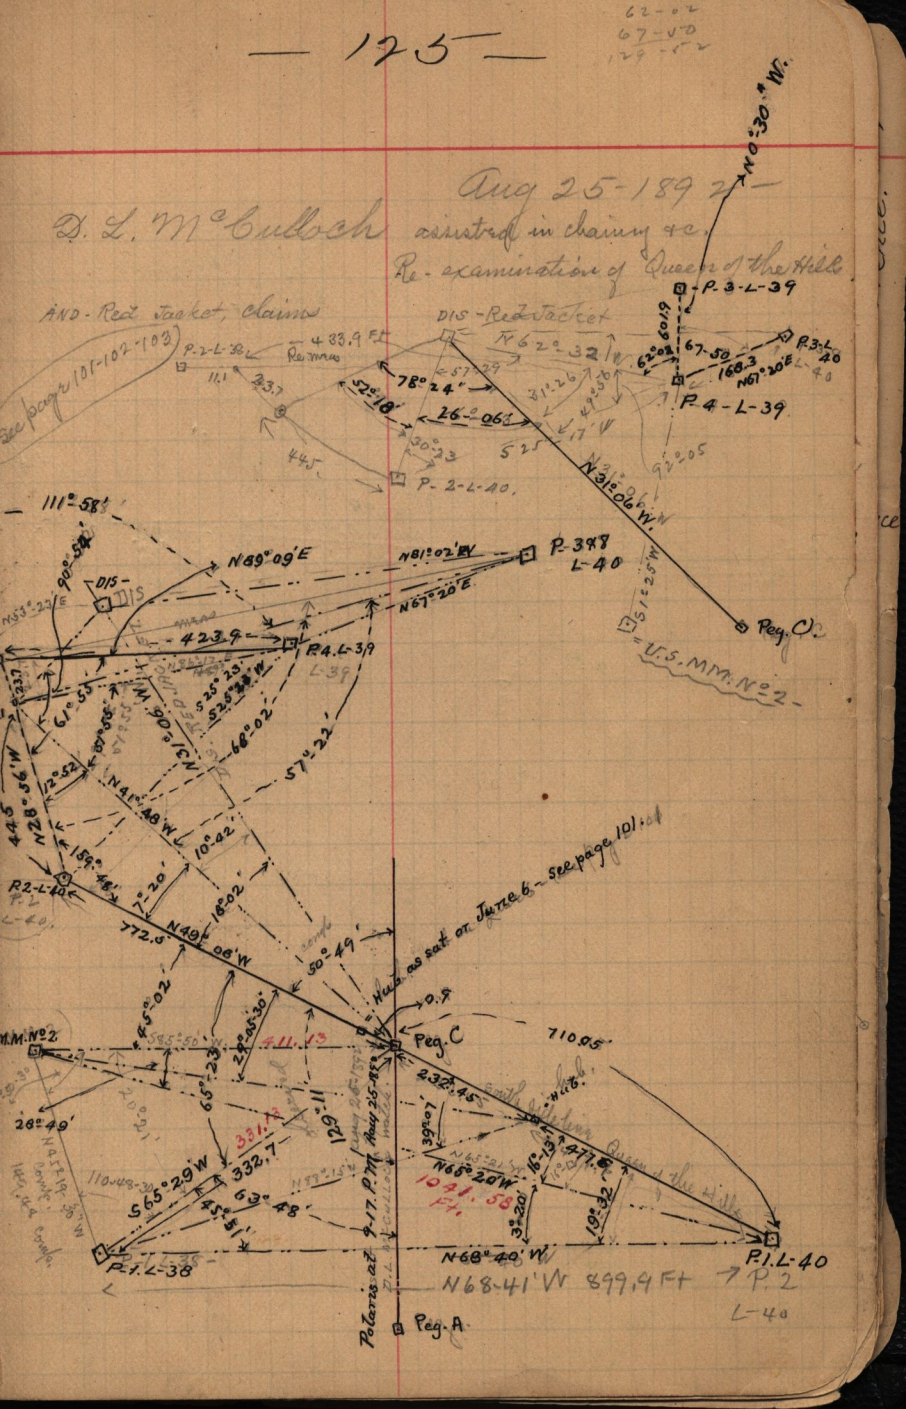
Aug 25-189 2
D. L. McCulloch assisted in chaining &c.
Re-examination of Queen of the Hill
AND-Red Jacket claims
DIS-Red Jacket
See page 101-102-103
P-2-L-39
Remains
433.9 Ft
N62°-32'W
P-3-L-39
P-4-L-39
P-3-L-40
N61°20'E
N0°30'W
78°24'
52°18'
26°06'
N31°06'W
P-2-L-40
111°58'
N89°09'E
N81°02'W
P-3-L-40
N67°20'E
423.9
P-4-L-39
Peg. C.
U.S. MM. N°2
DIS
90°54'
61°55'
68°02'
57°22'
N49°48'W
10°42'
189°48'
R2-L-40
772.0
N49°06'W
50°49'
Hills as sat on June 6 - See page 101-102
D.S
Peg C
710.05
M.M. N°2
411.13
45°02'
22°26'30"
65°23'
28°49'
2332.45
Hills
129°11'
331.12
332.7
S65°29'W
63°48'
45°51'
N65°20'W
1021.58 Ft.
477.6
39°07'
16°13'
19°32'
3°20'
N68°40'W
P.1.L-38
P.1.L-40
Polaris at 9-17. P.M. Aug 25-89
Peg. A
N68-41'W 899.4 Ft
P.2 L-40