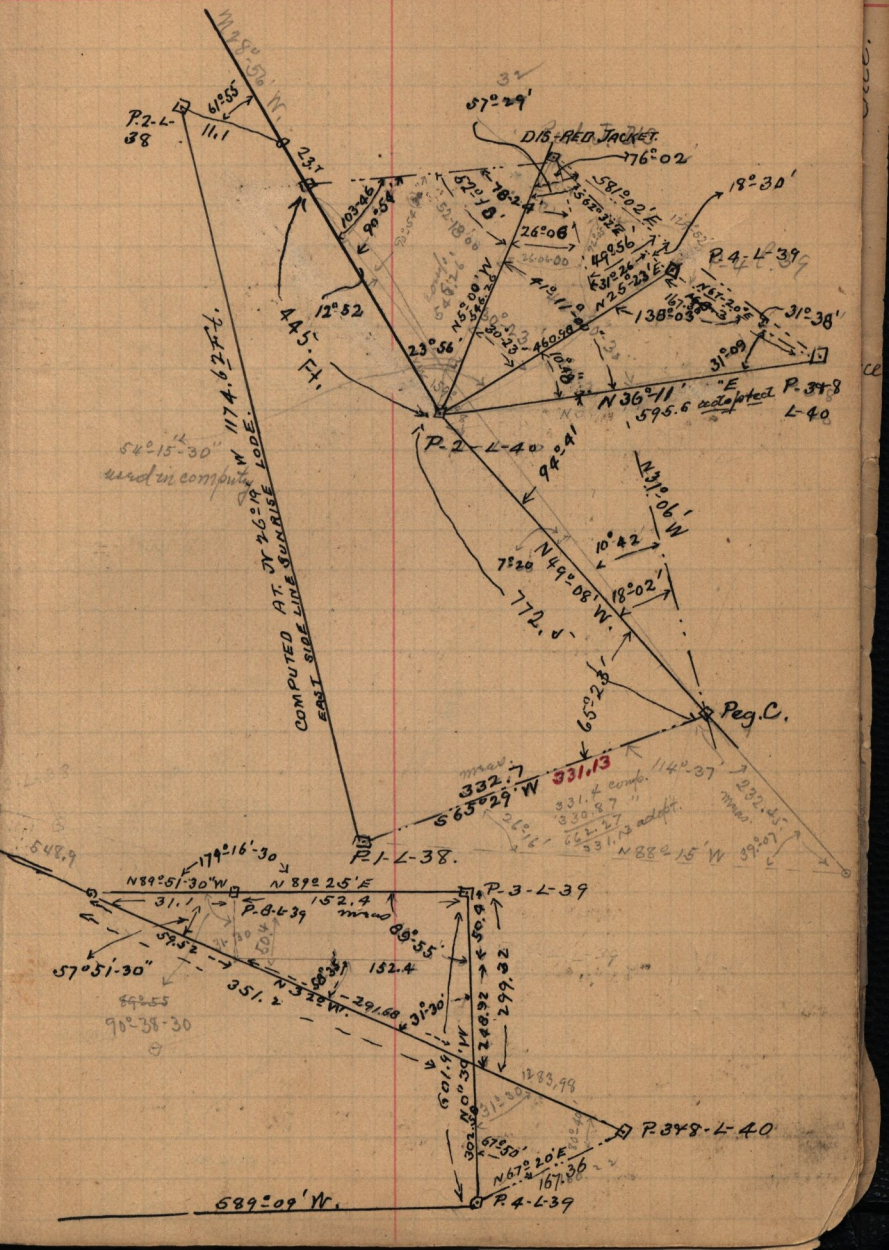
P.2-L-38
61°55'
11.1
23.7
103.46
90°54'
12°52
445 Ft.
23°56'
57°29'
DIS. RED JACKET
76°02
18°30'
78.24
62°18'
26°06'
49°56'
31°26'
N25°23'E
P.4-L-39
138°03'
31°38'
31°09
N36°11'
595.6 adopted
P.3+8 L-40
P-2-L-40
94°41'
N31°06'W
10°42
7°20
N49°08'W.
18°02'
772.5
65°23'
Peg.C.
332.7
S65°29'W
331.13
114°37'
N88°15'W
P.1-L-38.
COMPUTED AT N26°19'W 1174.62 Ft.
EAST SIDE LINE SUNRISE LODE.
54°15'30"
used in computing
548.9
179°16'30
N89°51'30"W
N89°25'E
P-3-L-39
31.1
P.B-L-39
152.4
89°55'
57°51'30"
59.52
152.4
351.2
N32°W.
291.68
31°30'
248.92
299.32
601.9
N0°30'W
302.50
67°50'
N67°20'E
167.36
P.3+8-L-40
P.4-L-39
589°09'W.