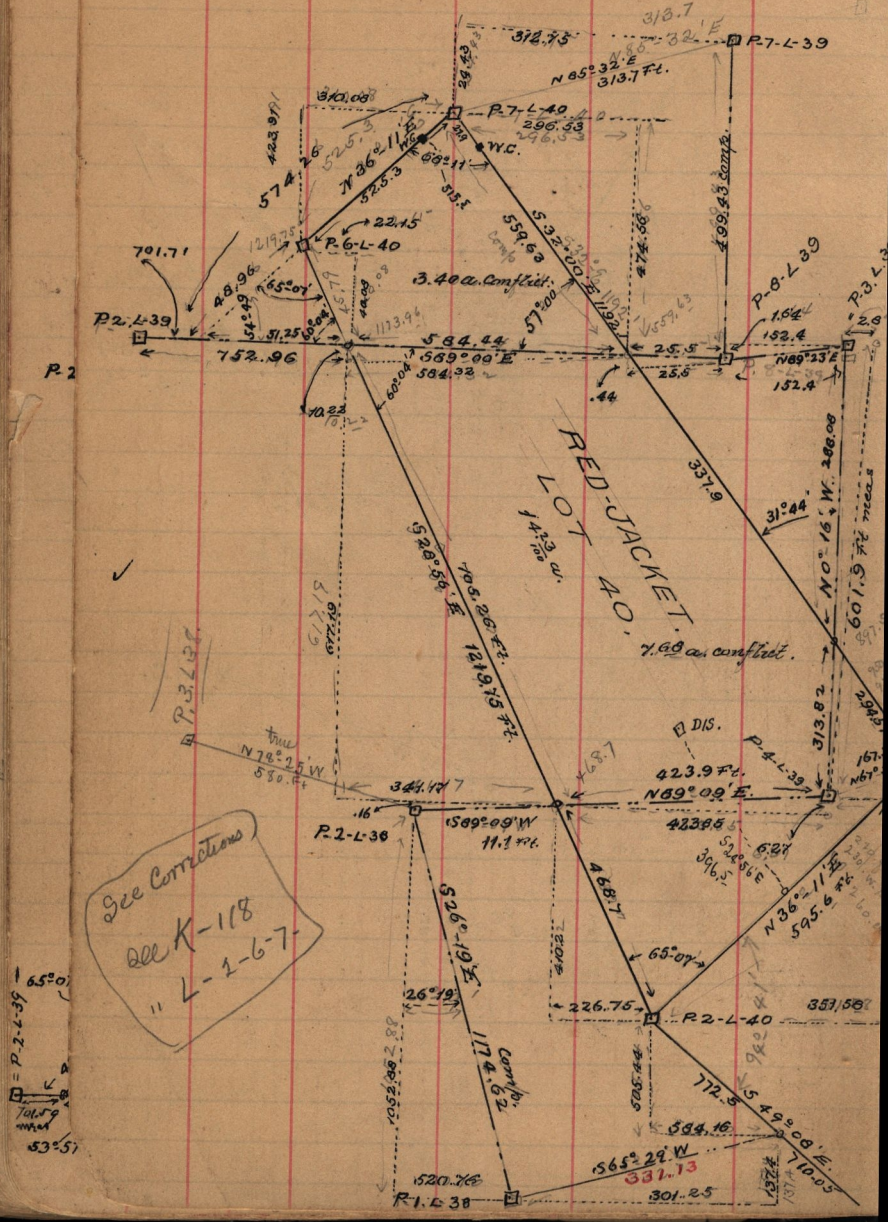Final adopted notes of the RED JACKET SURVE