Sept 10-1892

Survey made in South Ogden for C. S. Rapp.

Part of Lot 5 - B-10 - South Ogden Survey.
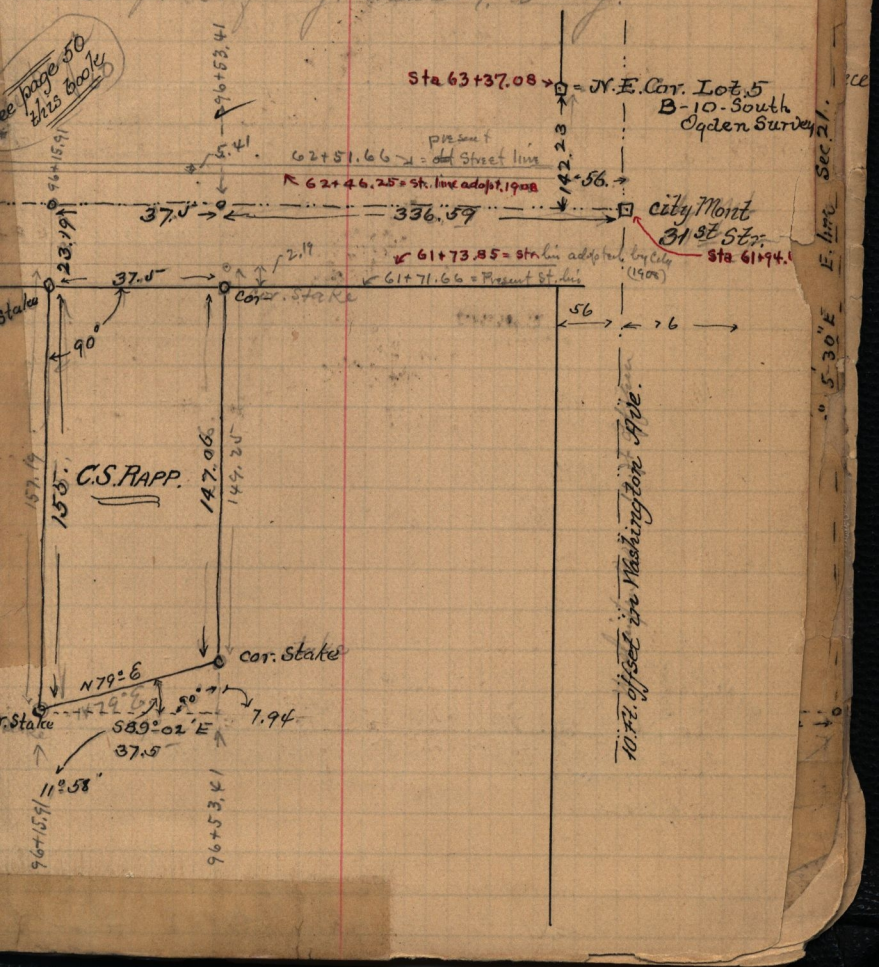
Beg. 165.4± ft South and 280.5± ft West from N.E. cor. said Lot 5, W 37.5 ft & 165.5 ft more or less to S. line of said Lot; N 79° E. 38. ft more or less to ft S. of beg. thence N. to beg.