See plat Book page 99.

137

— Sept 19-1892 — Survey at Plainfield

for Abraham Maw; Robt. W. Maw. Geo A. Boyd. Milo Sharp. & others
M. Sharp & Robt. Maw chainmen

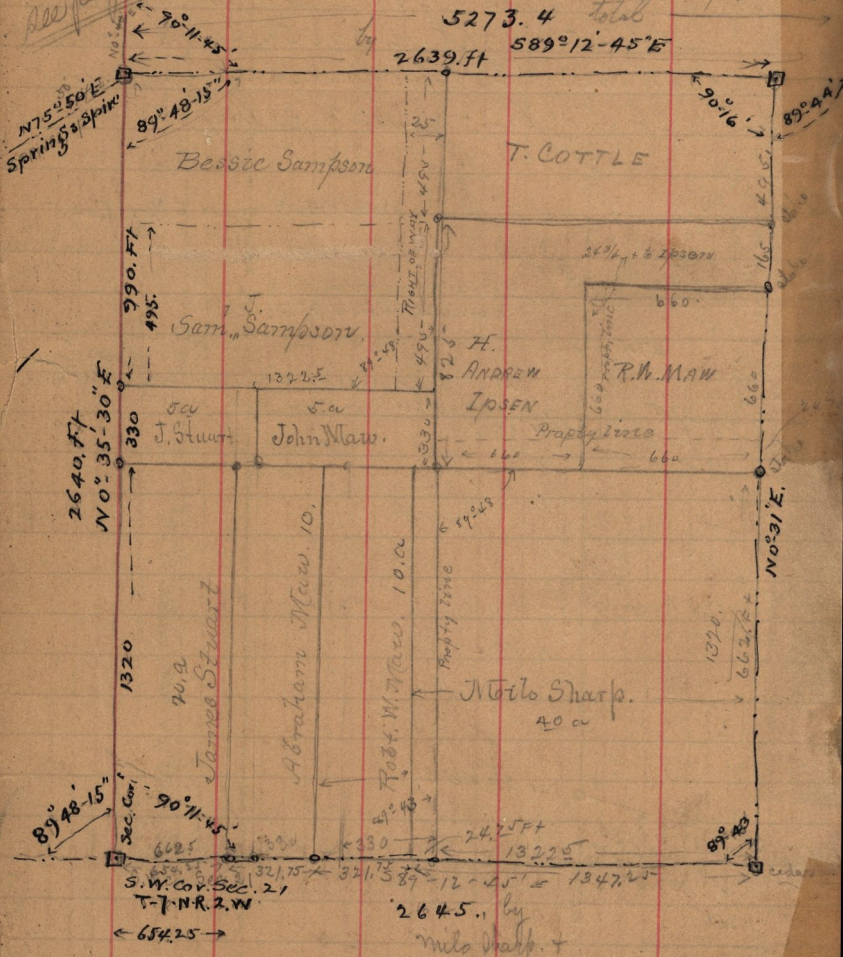

Note. A right of way to be provided at 33. ft. wide across the South end of S.W. ¼ Sec 21. ¾ of its area to be added to N. side of S.W. ¼