


Sept 20-21st 1892

Continuation of Survey at Plain City in N.E. 1/4 Sec
T. 7. N. R. 2. W. Milo Sharp & Lemon Moyes.

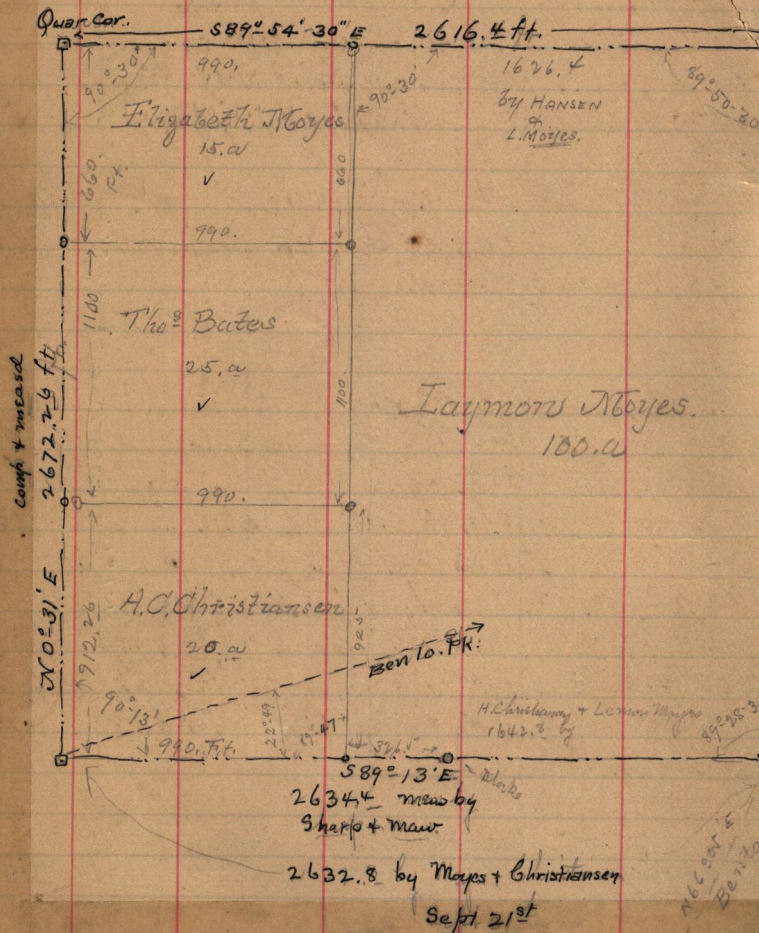

11 = P. 7. 2. 30

end of 5th.