Sept 29th 1892 — Survey made for Geo. H. Butler

of School Lot in Brooms Bench.
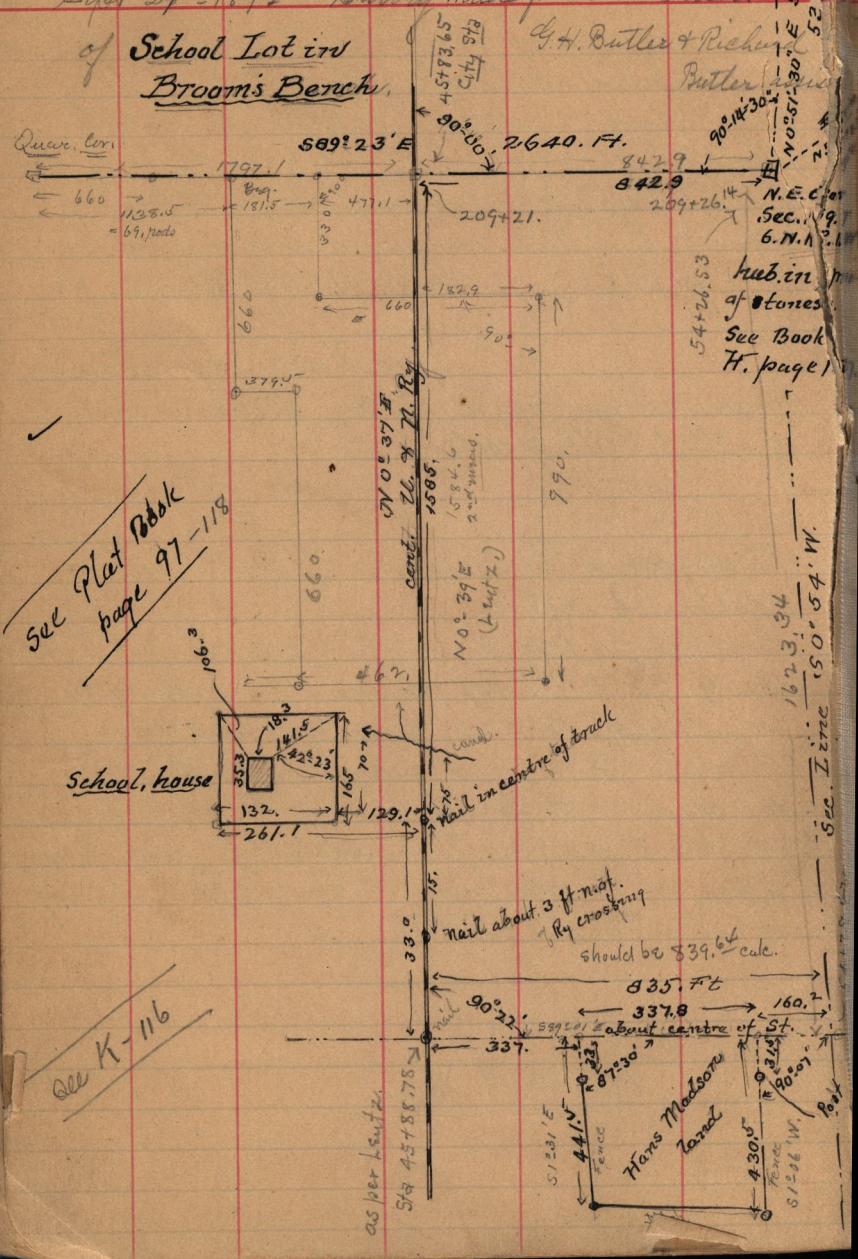
G.H. Butler & Richard Butler