

October 4-1892

Survey of pipe line for Paul Buss, in Sec 10-T. 5. N. R. 1-W

see page 115. this book

Begin at a point on the north line of the N. W. 1/4 of Sec 10. T. 5 N. R. 1. W. 1051.2 ft N. 89° 59' E. from the N. W. cor. thence

Run thence S. 45° 05' E 31.2 ft to point on west side of wagon track

Thence S 72° 08' E 226.0 top of hill = atake

Thence angle left 10° 34' = S 72° 42' E. 639.8


" " Right 19° 58' S 53° 44' E 1437.0

Thence " " 1° 00' = S 51° 44' E 738.5


mag. S 68° 45' E

" " S 51° 44' E 1437 ft

to spring of mouth of tunnel running due ~~west~~ ^{N 76° 32' E} 50 ft.

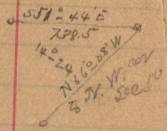

see plat book page 94

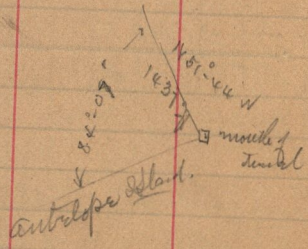

Also begining at the same place of begining as above described and run N 35° 38' W 518.5 thence N 10° 38' W. 200. to apt E. of Paul Buss barn 185. takes is S. line of Paul Buss.

Sec 10 T. 5 N. R. 1 W