Nov. 2 - 1892 - Survey of Hatch estate

E. 55 - Robert Winter to Josephus Hatch,
Pt N.W. 1/4 Sec 21 - T. 6. N. R. 1. W.
Beg. 13 1/2 rods S. of N.W. Cor. pcl 1/4 Sec,
thence E. 40. rods - S 82. rods
W. 40. rods N 82. rods to beg. 20 acres

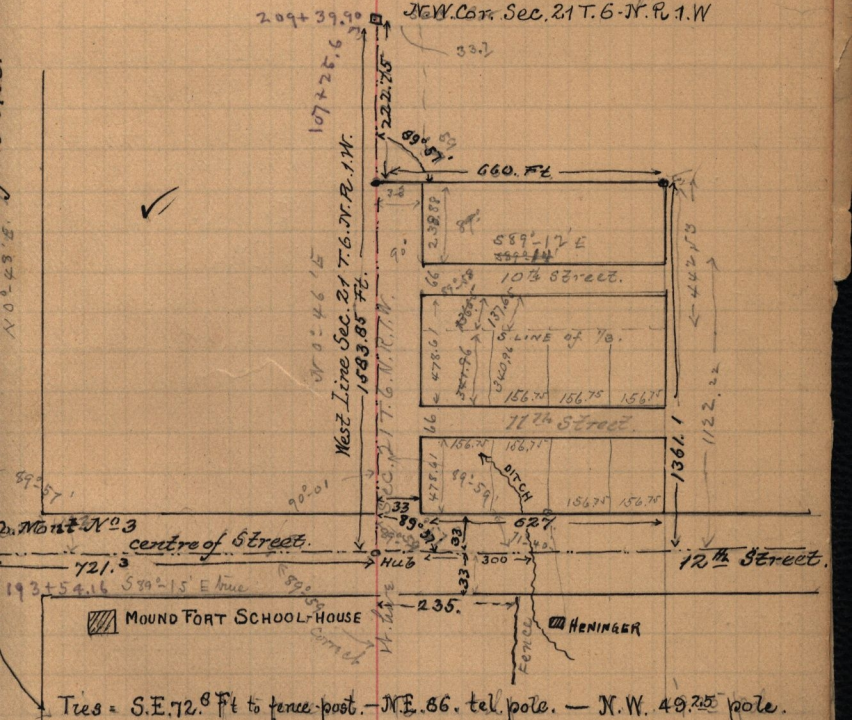

Tres - S.E. 72.8 Ft to fence post. - N.E. 86. tel. pole. - N.W. 49.25 pole.
S.W. 84.1 ft - pole - N.E. 9.2 lamp post. - Stone is close under East rail of Street-Ry.

After deducting 1/2 of 12th Street and a Street 33. ft wide along the west side of the above tract. there remains 19.11 acres. 1/3 of the same = 6.37 acres, which goes to widow Hatch, on the North side,

See - L-192 -