


24<sup>th</sup> St,

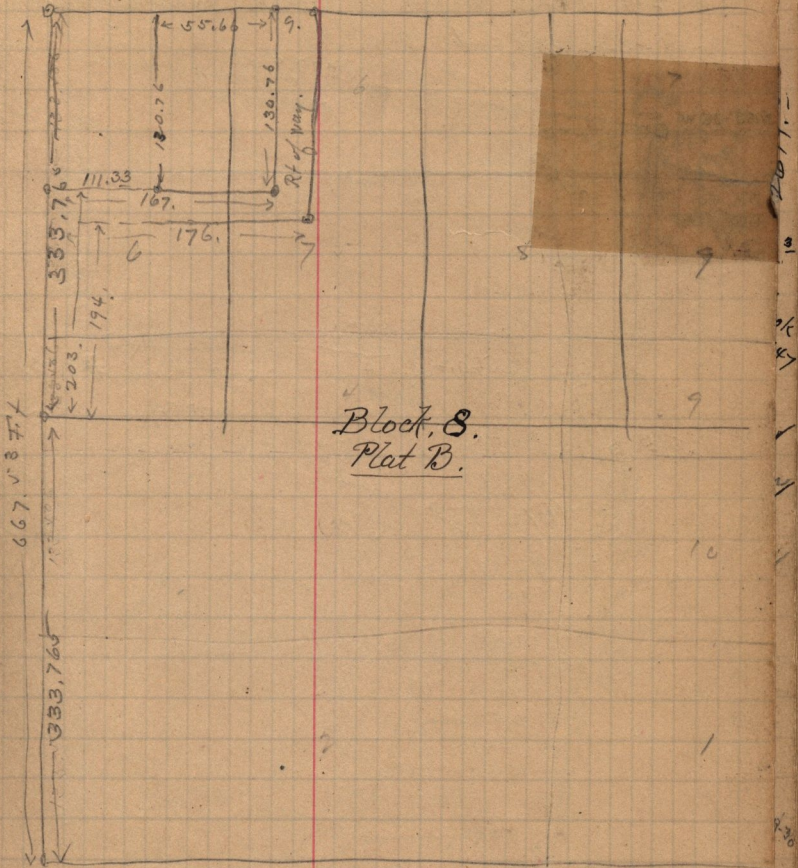

2011-  
3  
9  
10  
1  
9.30  
1.27  
1.22