Dec. 8th 1892 —

Survey made for Green Taylor in S.E. 1/4 Sec. 6. T. 6. N. R. 1. W.
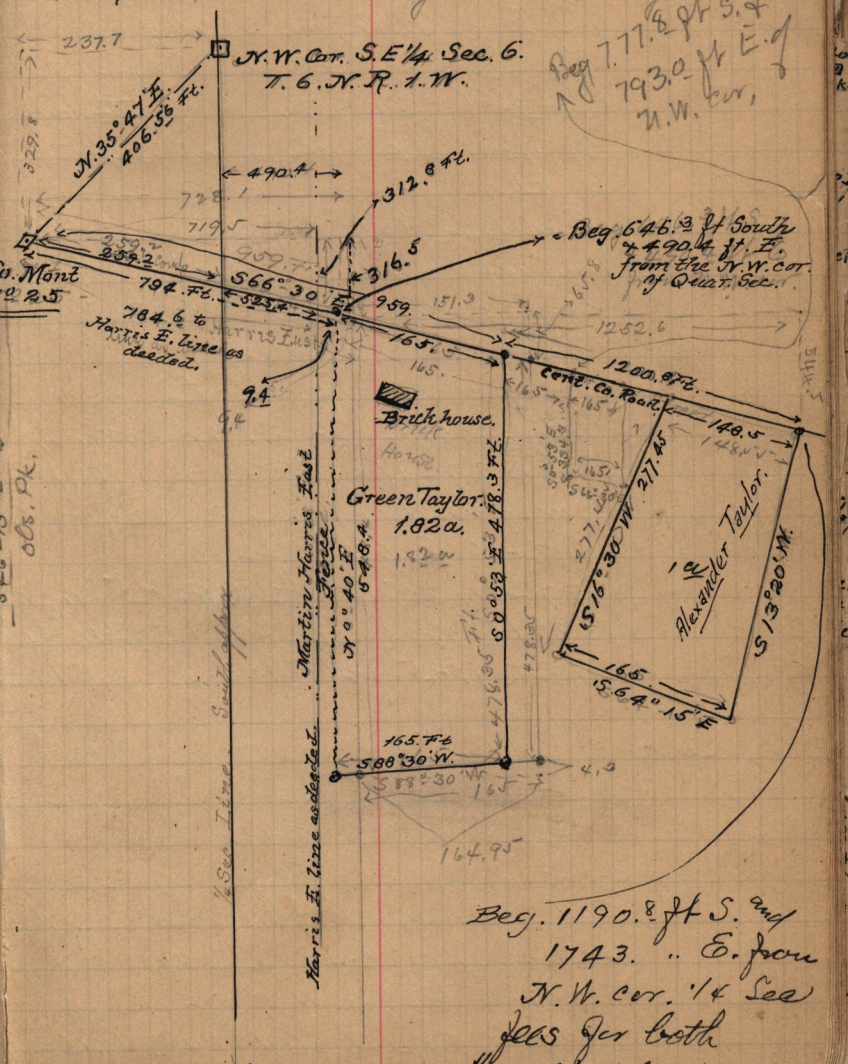
Green Taylor & Alex Taylor chain