of N.W. cor. of S.W. 1/4 Sec 7, - N 4°-34' E 3.03 ch, N 84°-15' W. 7.39 ch, S 3°-38' W 9.99 ch S 87° E 7.22 ch N 4°-34' E 6.61 ch to beg. contains 10.6 acres.

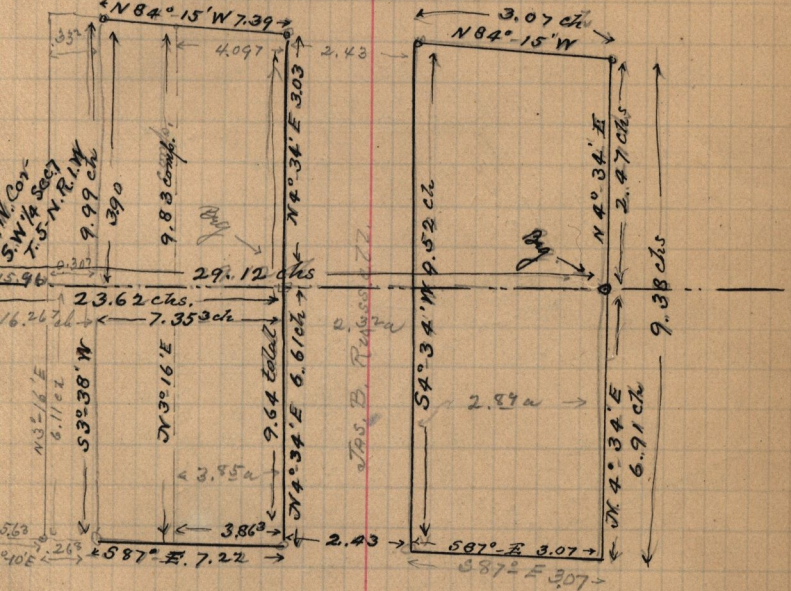

Issued by self.

Described as follows in deed: " Pt N.W. 1/4 of S.W 1/4 Sec 7. T.5-N.R.1.W. Beg. at point 29.12 ch. E. of N.W. cor. S.W 1/4 Sec 7. Running N. 4°-34' E. 2.47 ch, N. 84°-15' W. 3.07 ch, S 4°-34' W. 9.52 ch, S87°-E 3.07 ch N 4°-34' E. 6.91 ch to beg. 2.89 a. Also. beg. at a point 23.62 ch E. of said cor of Said 1/4 Sec, thence N. 4°-34' E. 3.03 ch, N 84°-15' W 4.097 ch, thence S 3°-16' W 9.83 ch, S 87°-E 3.86 3 ch, thence N 4°-34' E 6.61 ch to beg. 3.85 acres

Fees $1.50