

N 55° 25' E 578.25 =
 N 214.69 + E 311.41

JAN. 13-1893 -

Survey made for
 W.W. Tracy, & C. Zeimer,
 in Sec 19, T. 6, N. R. 1, W.
 W. Amidars lead, and
 C. Zeimer rear chain

22

Cor. as used by
 Ry. Co. and others

572° 27' W.
 702.65

3
 X. Line Sec.
 T. 6. N.


Cont'd C. P. R. R.
 S. 18° 28' E.

Repled Book
 Page 97.
 See also page 29
 of this book.

Fence

centre ditch

Fence


Fence

Fence


PLAIN CITY CANAL


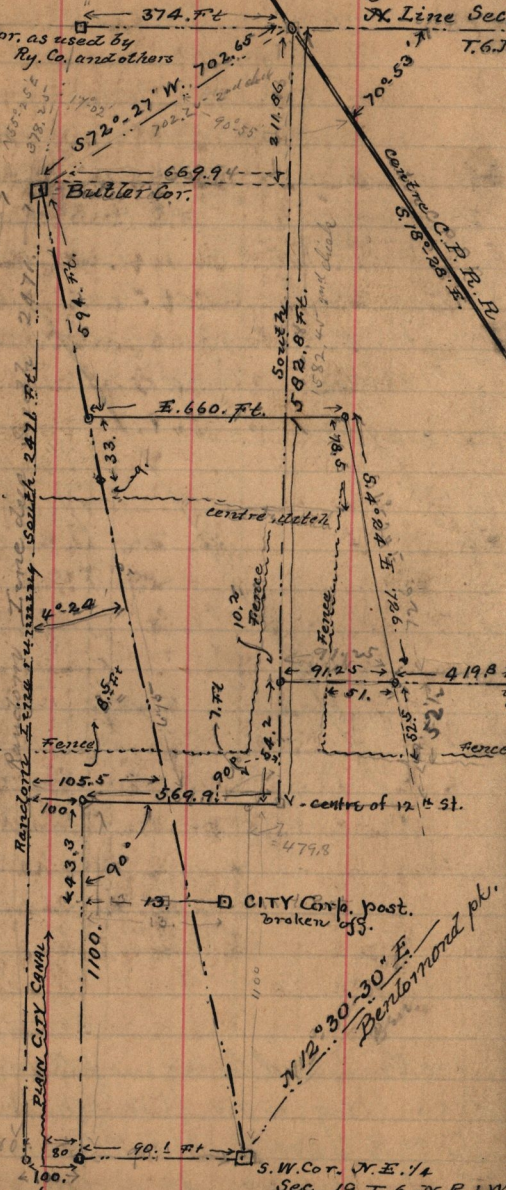

712° 30' 30" E.
 S.W. Cor. N.E. 1/4
 Sec. 19, T. 6. N. R. 1, W.
 Stone