


Price old house
now Blairs.

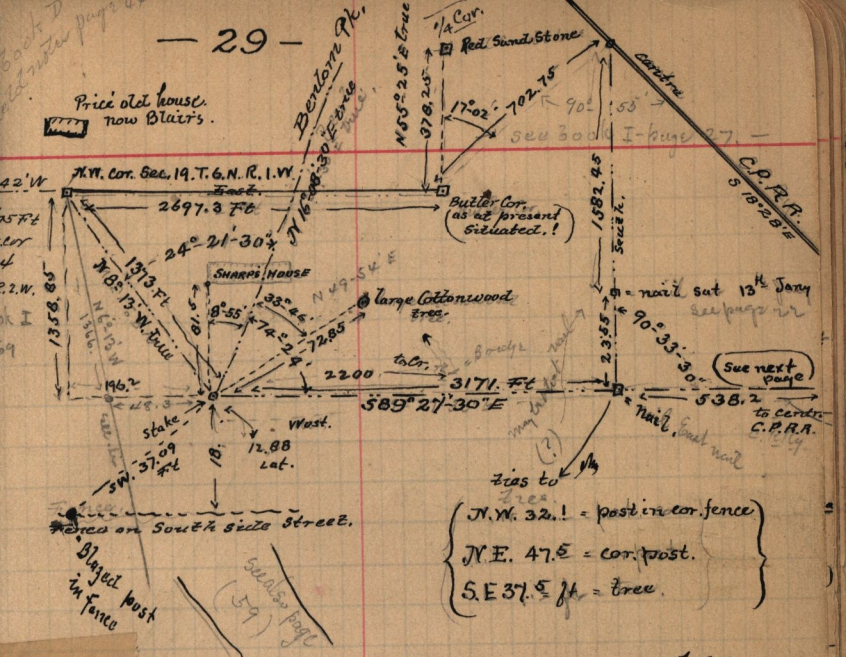

- { N.W. 32.1 = post in cor. fence
- { N.E. 47.5 = cor. post.
- { S.E. 37.5 ft = tree.

January 26-1893 - Survey made for W^m W Tracy & Chas Zerner

In Sec. 19. T. 6. N. R. 1. W.

E. 72. Helon H. Tracy to W^m Butler, Jan. 7. 1870. cons.
cont. 30. Pt N.E. 1/4 Sec. 19. T. 6. N. R. 1. W. Beg. N.W. cor.
sd. 1/4 Sec. E. 40 r. S 80 r. W 40 r. N 80. r to beg. 20. a.

Survey continued on page 30.

& pages 88-89.

See plat Book
page 97-118
See Field Book I
page 27 & 69
See pages 59-139.

See also page 22 this book.

Stake { N.W. 76. ft. to S.W. cor
 Sharp's house
 S.W. 37.1 to bladed post
 S. 15.0 ft. to fence