


Feb. 11-1893

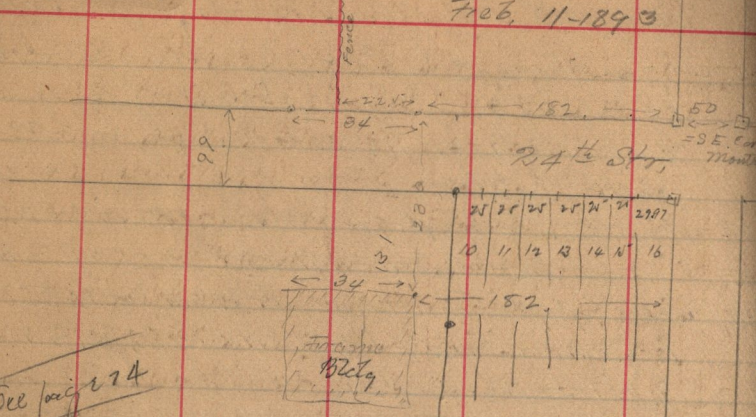

See page 74

West Ogden Heights