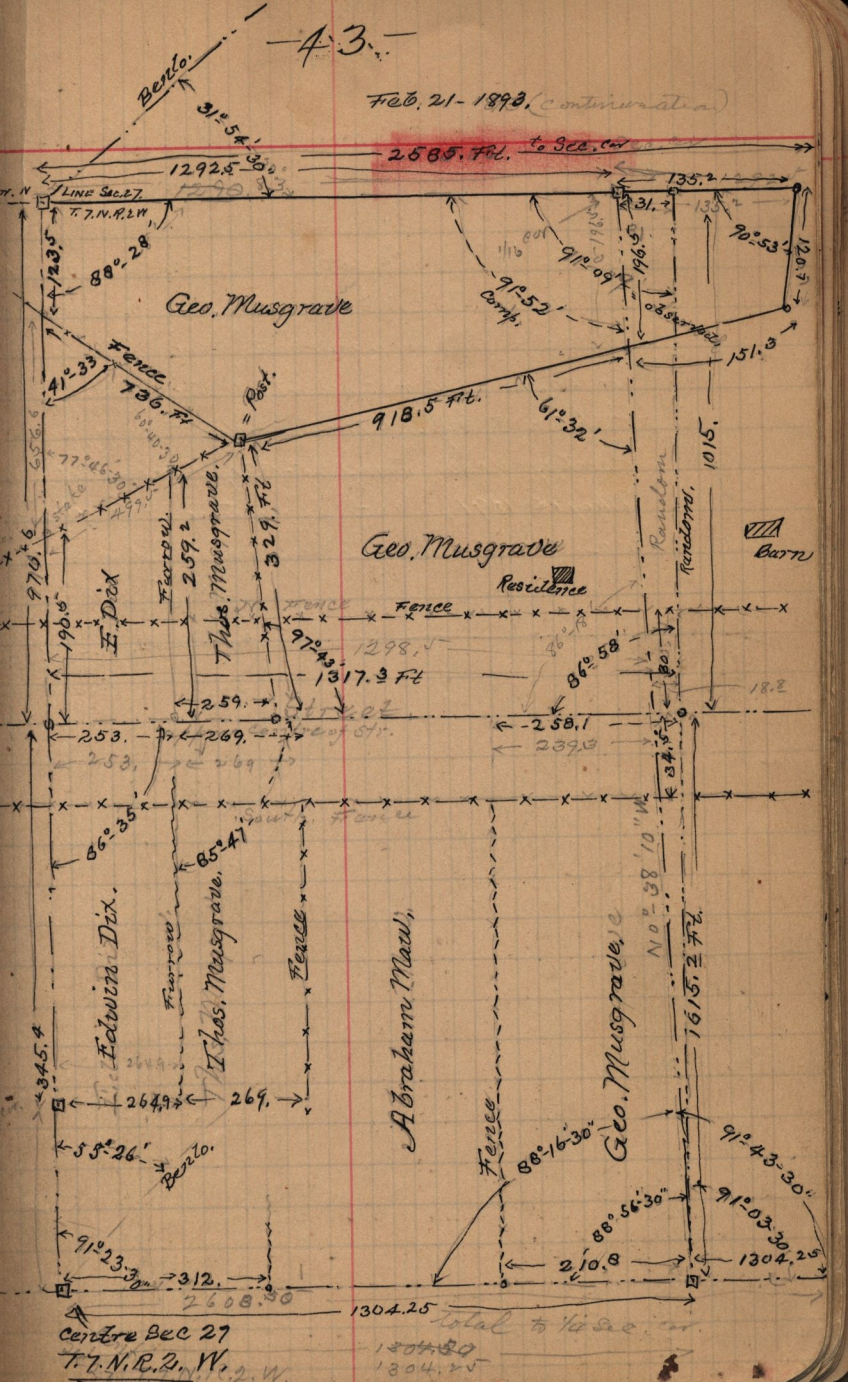Feb. 21- 1893. (continuation)