


17-page 160 Jens Christiansen to Robert E. Gaddes,
 July 14-1892, \$220. N¹/₂N, W¹/₄ & S, W¹/₄
 of N, W¹/₄ Sec 23, T. 7. N. R. 2. W. Rec. July 14-
 Surveyed Feb. 23-1893.

See sketch on ^{previous} ~~last~~ page.

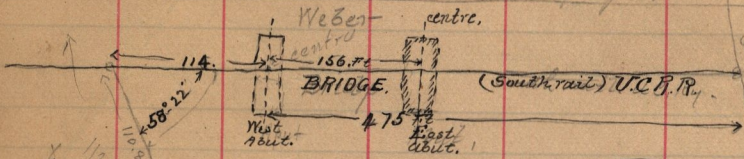

Feb 24-1893,

James Johnston, or

H.D. Peterson,

{ Survey of mill ditch for
 Weber Co. Farmers & millin
 Co. in S.E. 1/4 Sec. 30. T. 6. N. R.

