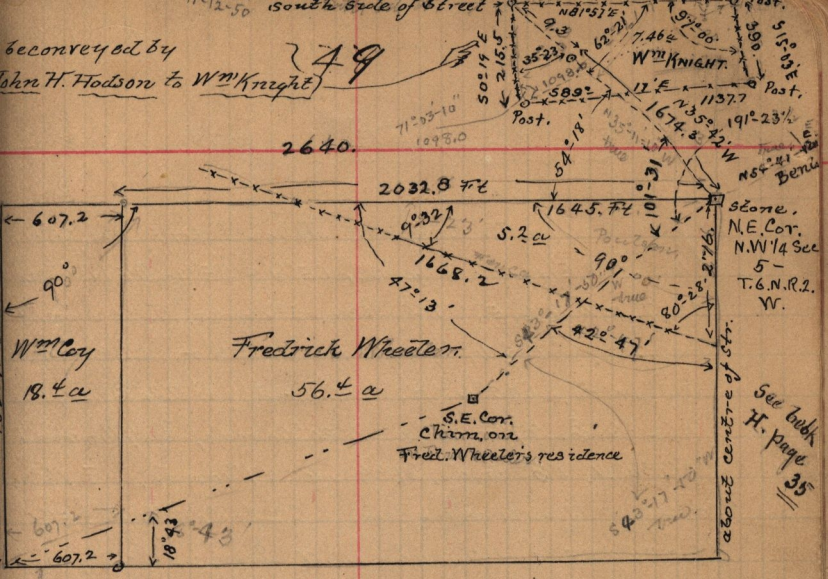

Feb. 27 - 1893

Survey made for Fredrick Wheeler. at
Plain City, Weber. Co. Utah,

Fred Wheeler & Poulson
Chainmen,

Copy, des. put into deed, by self. of Land to be conv.d
by John H. Hodson to Wm Knight, as above. Pt Sec. 32. T. 7. N. R. 2. W.
Beg. 1683.6 Ft N 35°42' W from S.E. Cor. S.W 1/4 Sec. 32, - S 0°19' E 2155
Ft. S 89°17' E 1137.1 Ft. N 15°03' W 423.2 Ft. to centre of Str. S 81°57' W
1039.5 Ft. along cent. Str. S 0°19' E. 33.3 ft. to beg. 8.25 a.

Issued Apr. 3-1893.

see book D page 58
" " H. " 35.
" " B " 178

April -19-1917-
The above point of beg.
was re-measured by Lentz.
& found to be 2183.6 ft.
N 35°42' W. from 1/4 cor