Survey of the John Lyon tract Feb. 28 - 1893

F. 442. Morgan Co. Records.

Mary T. Lyon to John Lyon, Nov. 25 -
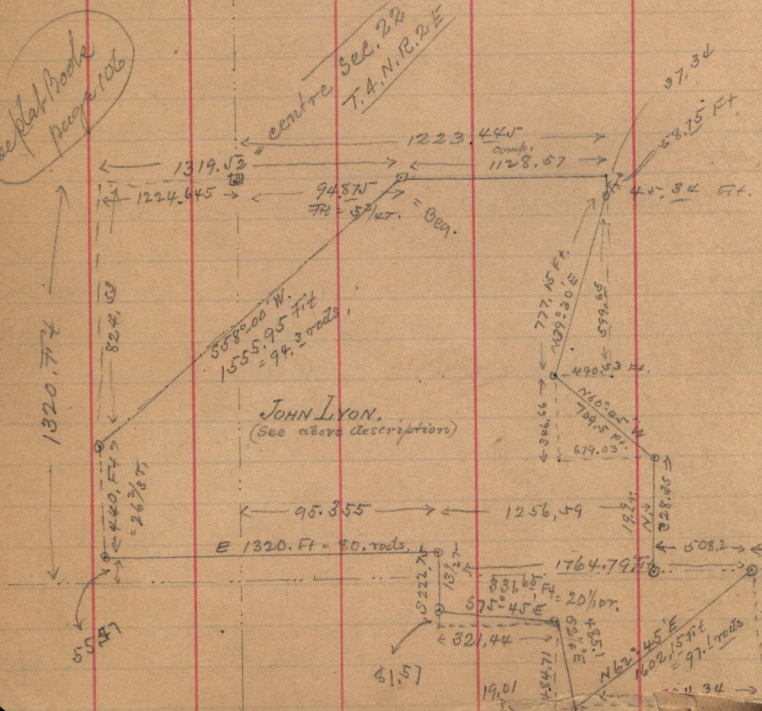
10. Pt N.E¼ of S.W¼ and SE¼ & SE¼ of N.E¼ of Sec
22. T. 4. N.R. 2. E. 1st Beg. 5¾ rods, E. of centre
Sec. 22, S 58° W. 94⅗ rds. S 26⅔ r. E 80. ro
S 13½ rods, S 75¾° E. 20.⅒ rods, S 2¼° E 29¼
N 62¾° E. 97⅒ rods, W 30.⅗ rods, N 19⅒ rod
N 60¾° W. 43⅘ rods, N. 39½° E. 47⅒ rods, E 76
⅗ Beg. 15 a. more or. less. 2nd N.E¼ of S.E¼
S.E¼ of N.E¼ of the aforesaid Sec 22, contg 80.
In all 155. acres. (see plat & Traverse
(1st piece contains 69.62 ac by comp.) & Survey on next p