
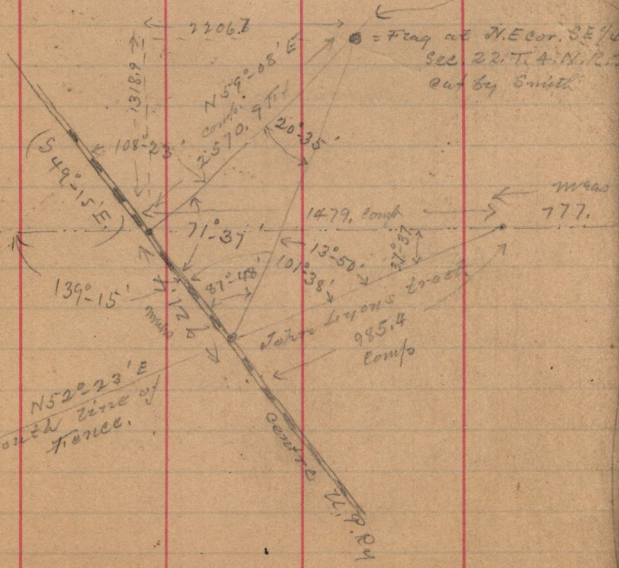


March 1-1893,

From previous page

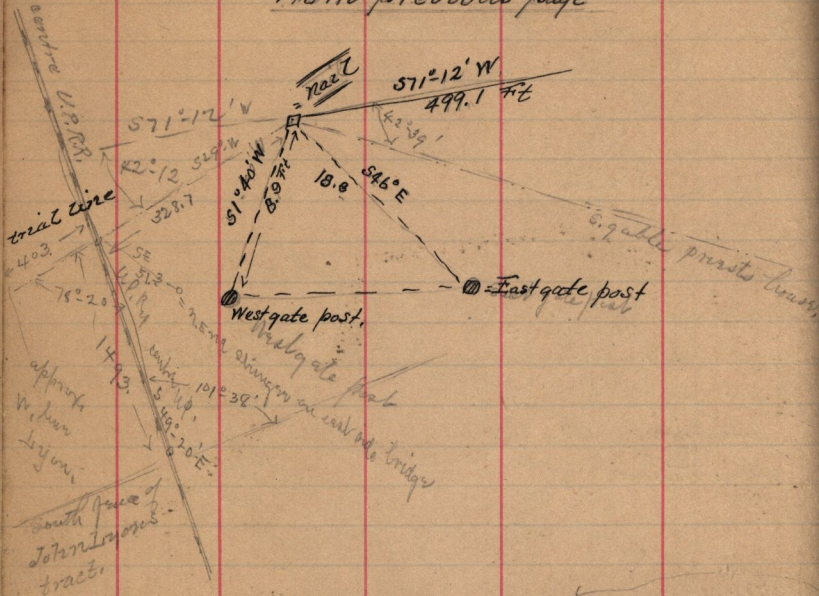

See Plat Book page 106