


Mar. 1-1893

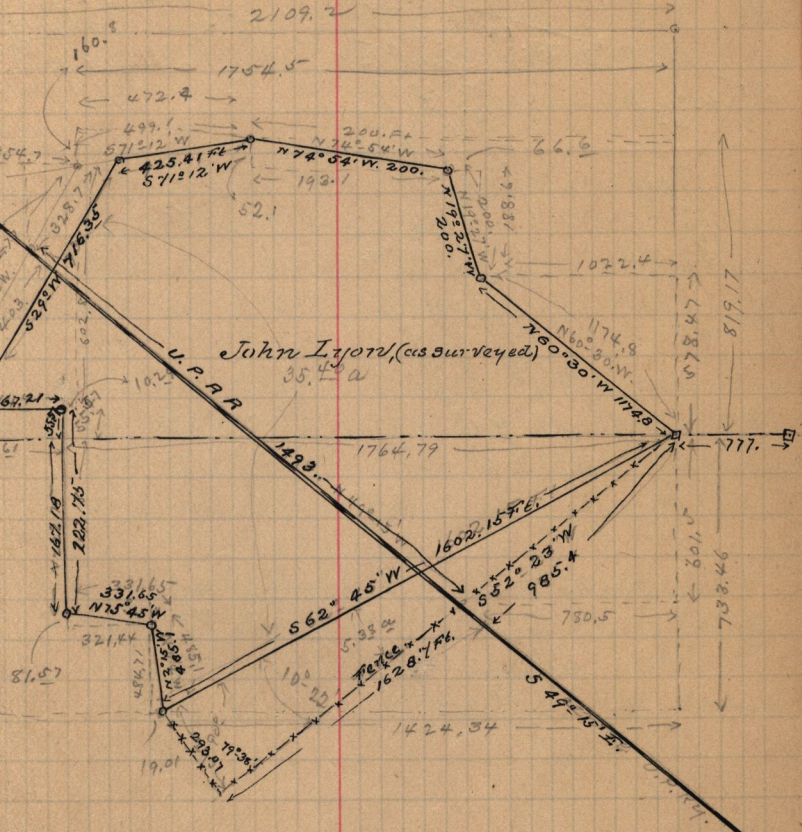

(see page 54.)

See Plot Book page 106