


Mar 1-1893

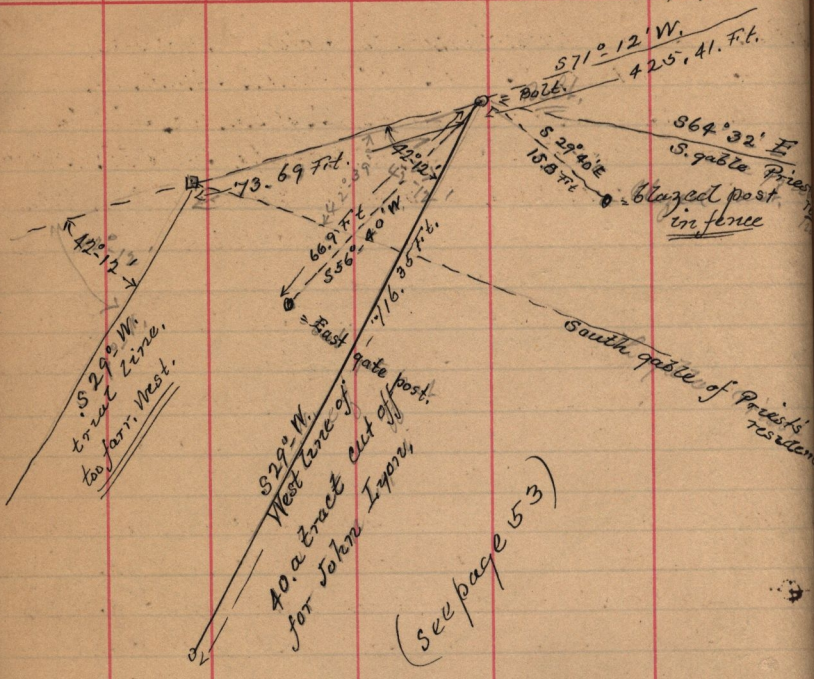

(see page 53)

see Plat Book page 106