

Rostan estate

Mar 2-1893,

611. Rasmus Christofferson to John M. Rostan,
 July 19-1884, \$1. Pt. N. E 1/4 Sec. 17. T. 6. N. R. 1. W.
 Beg. 2:72 chs. N ^{and} 3:75 chs. E. of S.W. cor. said 1/4
 Sec. N 1°23' E. 15:58 chs, E. 6:96 chs, S 5 1/4° E. 4:56 chs
 S 2°30' E 11:09 chs, S 89°45' W. 8:20 ch to beg, 11.9/100



Recorded Aug. 23-1884,

481-482, Samuel Gates, to John M. Rostan,
 June 27-1872, \$4.00 Pt. N. W 1/4 Sec. 17. T. 6. N. R. 1. W.
 Beg. 18:35 chs. N ^{and} 5:70 ch, W. of S. E. cor. sd 1/4 Sec,
 N 6:65 ch, W. 3:61 ch, S. 2:65 ch, W. 0:16 ch, S. 4:00 chs,
 E 4:15 ch, to beg. Recorded July 1-1872,

365, John M. Rostan to John W. Wheeler, Mar. 16-1889,
 \$100. Pt N. W 1/4 Sec, 17. T. 6. N. R. 1. W. Beg, 18:35 ch. N. ^{and}
 5:70 ch. W. of S. E. Cor. sd 1/4 Sec, N. 20. r. W 4. rods,
 S. 20. rods, E. 4. rods to beg. Rec. Mar. 18-1889.

3-278. John M. Rostan to James Leavitt, Aug. 28-
 1889, \$350. Pt N. E 1/4 Sec, 17. T. 6. N. R. 1. W. Beg. 18:30 ch. N,
 and, 3:75 ch. E. of S.W. Cor. sd 1/4 Sec, S 1°23' W,
 22. rods, E. 4. rods N 1°23' E. 22. rods, W 4. rods
 to beg.

2. E each

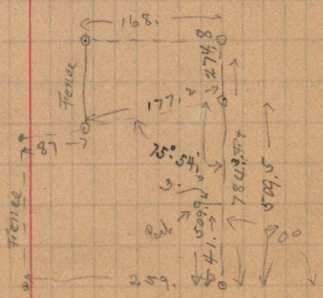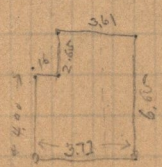

Celia Rostan
Wheeler