


Subdivision of Reston's Estate, Mar. 3-1893 -

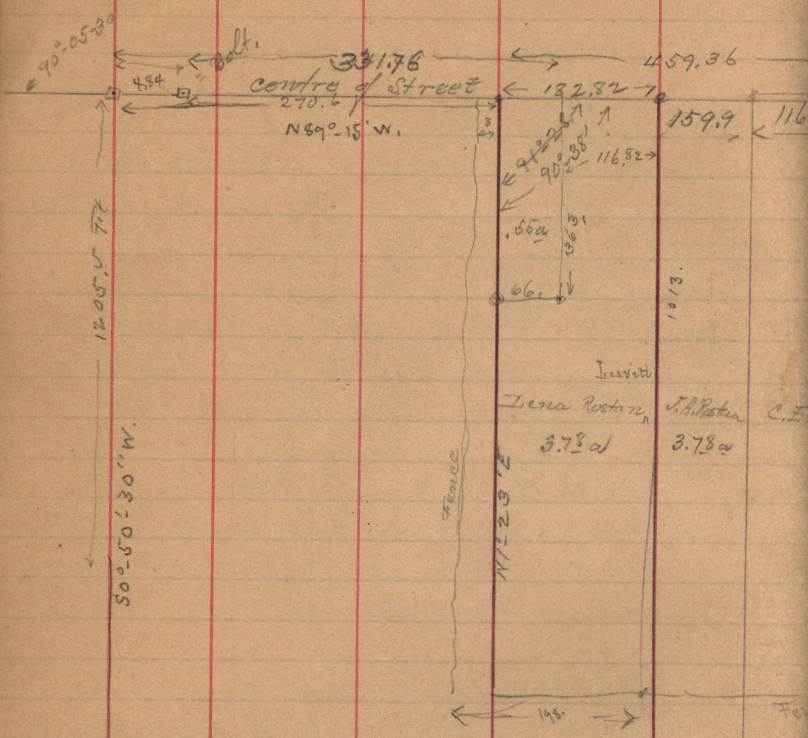

□ S.W. 1/4, J.E. 1/4 Sec. 17,
T. 6. N. R. 1. W.

see also, Book G. pages 129. Field notes.